

WATER SERVICE RECORD

Name Ralph J. Frissore

Service No. *2568* 75Address *149* Bedford Street

Location

~~Repair~~ ~~Renewal~~ ~~New Service~~ *Com. 5-9-55*

Date	Material	Amount	Total	Date	Amount
4/5/55	Labor	1 85		3-21-55	Deposited 25 00
	10% overhead	19	2 04	5-20-55	Paid (9 36
	70' - 3/4" copper tubing @ .3693	25 85			<u>NON CHARGE</u> 12 4 36
	1 - 3/4" C x 1/2" I.W.H. stop & waste	4 00		4/5/55	Labor 1 85
	1 - 3/4" C. union		1 72	6' - 3/4" copper tubing @ .3693	2 22
	1 hr. trucking		75	1 - 3/4" C. corp-cock	4 33
			34 36	1 - 3/4" C. curb-cock	4 67
				1 box and rod	3 90
				1 - 1/2" straight tail pc.	50
				1 - 1/2" offset tail pc.	50
				1 hr. trucking	75
					<u>18 72</u>


P. J. Sent 5-10-55

DATE _____

TOWN OF LEXINGTON — BOARD OF PUBLIC WORKS

WATER DIVISION

Sketch of Service Here

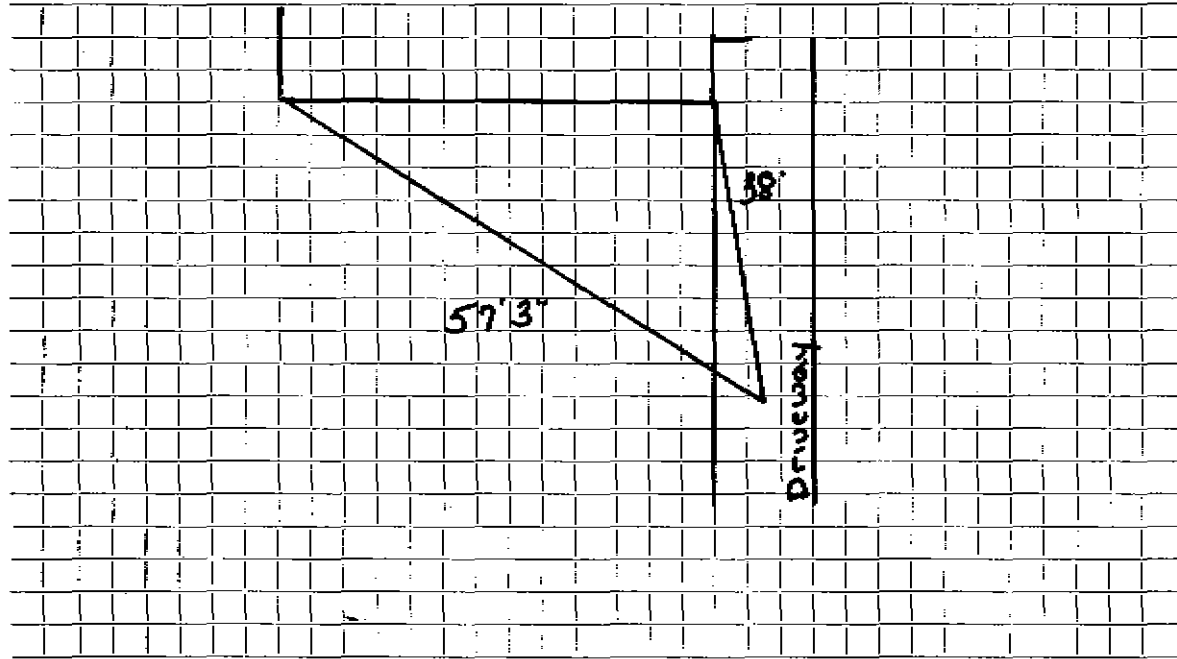

Connection made in Street. Work completed

Remarks:
.....
.....