

Name New Fire Station  
45

Service No. 127 3239

Address Bedford Street

Lexington, Mass.

Location Bedford Street

Kind of Pipe

Size

Size of Main

~~Repair - Renewal~~ - New Service

Location

Date	Material	Amount	Total	Date	Amount
May 25, '46	Labor	27 45		<i>May 21, '46</i>	<i>Paul</i>
28, '46	"	6 08			
June 20, '46	"	<u>4 05</u>	37 58		<i>88 66</i>
	10% Overhead		3 76		
	48' - 2" C. L. Pipe @.38		21 60		
	1 - 2" Gate Valve		9 46		
	2 - 2" Close Nipple		68		
	1 - 2" Elbow		76		
	Trucking 2 hrs. @.75		1 50		
	Patching 8' x 5'		<u>13 32</u>		
			88 66		
	Labor				

Hadley Press, Inc., Lexington

DATE \_\_\_\_\_

# TOWN OF LEXINGTON--BOARD OF PUBLIC WORKS

## WATER DIVISION

The undersigned applies for a supply of water at No. \_\_\_\_\_ St. and hereby agrees to comply with the rules and regulations as now, or at any future time, established by the Board of Selectmen.

Am't. of Estimate \$ \_\_\_\_\_

Am't. Paid \$ \_\_\_\_\_


Builder \_\_\_\_\_

#45

Owner \_\_\_\_\_

Address \_\_\_\_\_

Sketch of Service Here

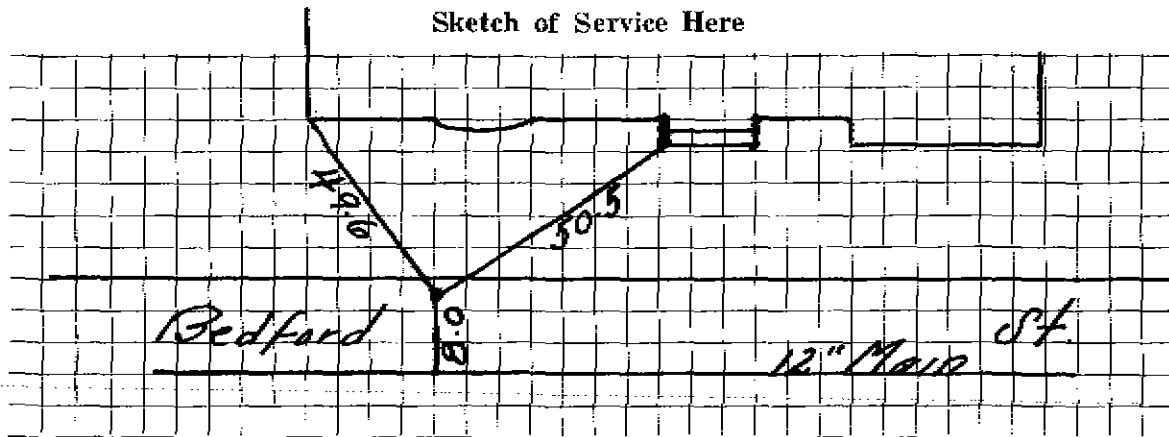

Connection made in \_\_\_\_\_ Street.

Work completed \_\_\_\_\_ 19

Remarks: