

# 4520

WATER SERVICE RECORD

Name Richard H. Soule

Service No. 65

Address 451 Bedford Street

Location

~~REPAIR~~ ~~REPAIR~~ — New Service

*Com. 5-9-55*

Date	Material	Amount	Total	Date	Amount
4/4/55	Labor	1 85		5-11-55	Deposited 25 00
	10% overhead	19	2 04	5-9-55	Paid ( 9 36
	70' - 3/4" copper tubing@.3693	25 85	25 85		NON CHARGE 18 36
	1 - 3/4" C. x 1/2" I.K.H. stop & waste	4 00	4 00	4/4/55	Labor 1 85
	1 - 3/4" C. union		1 72	6' - 3/4" copper tubing@.3693	2 22
	1 - hr. trucking		75	1 - 3/4" C. corp-cock	4 33
			34 36	1 - 3/4" C. curb-cock	4 67
				1 box and rod	3 00
				1 - 1/2" straight tail pc.	50
				1 - 3/8" offset tail pc.	50
				1 hr. trucking	75
					18 72


DATE \_\_\_\_\_

TOWN OF LEXINGTON — BOARD OF PUBLIC WORKS

WATER DIVISION

Sketch of Service Here

*451 Bedford*

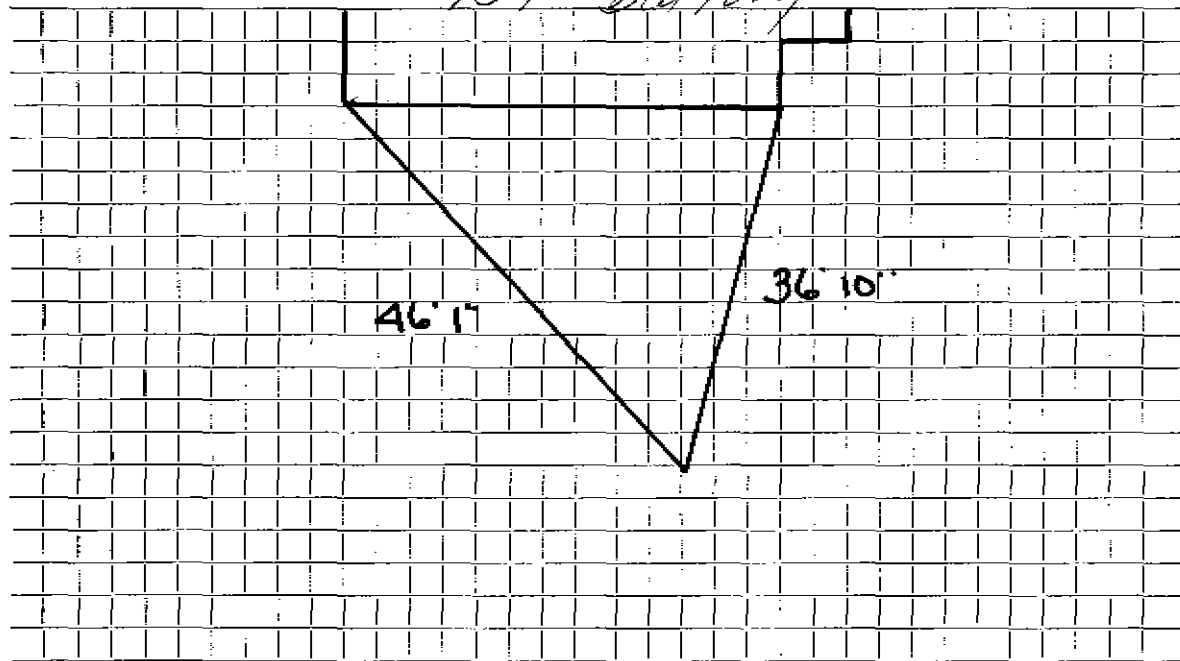

Connection made in ..... Street. Work completed .....

Remarks: .....

.....

.....