


DATE _____

TOWN OF LEXINGTON — BOARD OF PUBLIC WORKS

WATER DIVISION

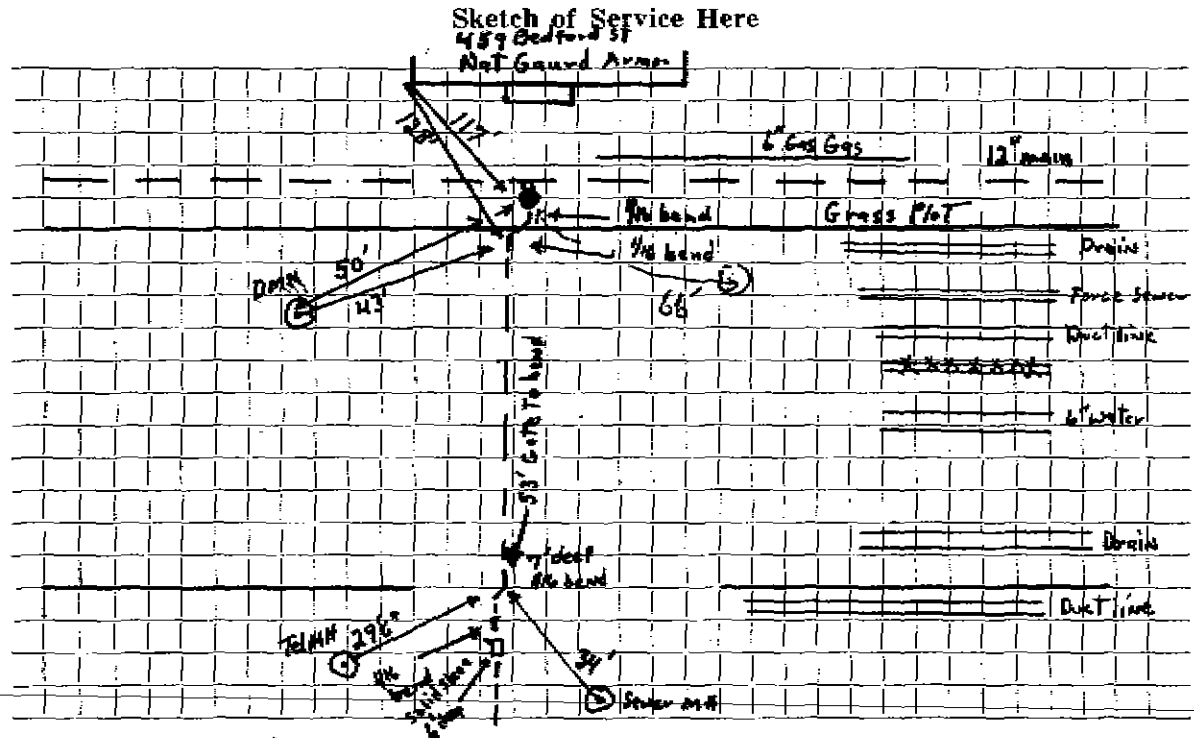

Connection made in Bedford St. 8" main D.F.P. Street. Work completed 8-11-81

Remarks: 12" 4" 8" T-5-6 Lead Joints on Service, main goes under all Utility's


State Armory
Bedford Street



190' - 3" water - they will
install. 130' - 6" sewer -
they will install from the
lot line. They will supply us

with a 12 x 6 tapping sleeve and gate,
either Mueller or Darling and the
6" cement lined cast iron pipe necessary
to go to the lot line. They will
supply us with the sewer pipe to go
to the lot line. The Town will dig
and install the pipe from the mains
to the lot line. The only charge the
Town will make to the contractor will
be for the necessary labor and equipment
to dig the trench and lay the pipe to
the lot lines. Patching of the trench
will also be charged to the contractor.
The contractor will deposit \$500. for
water and \$250. for sewer. Contractor
will furnish 2 \blacklozenge 2" meters - Trident
direct reading set up as a battery.

J. J. [unclear]

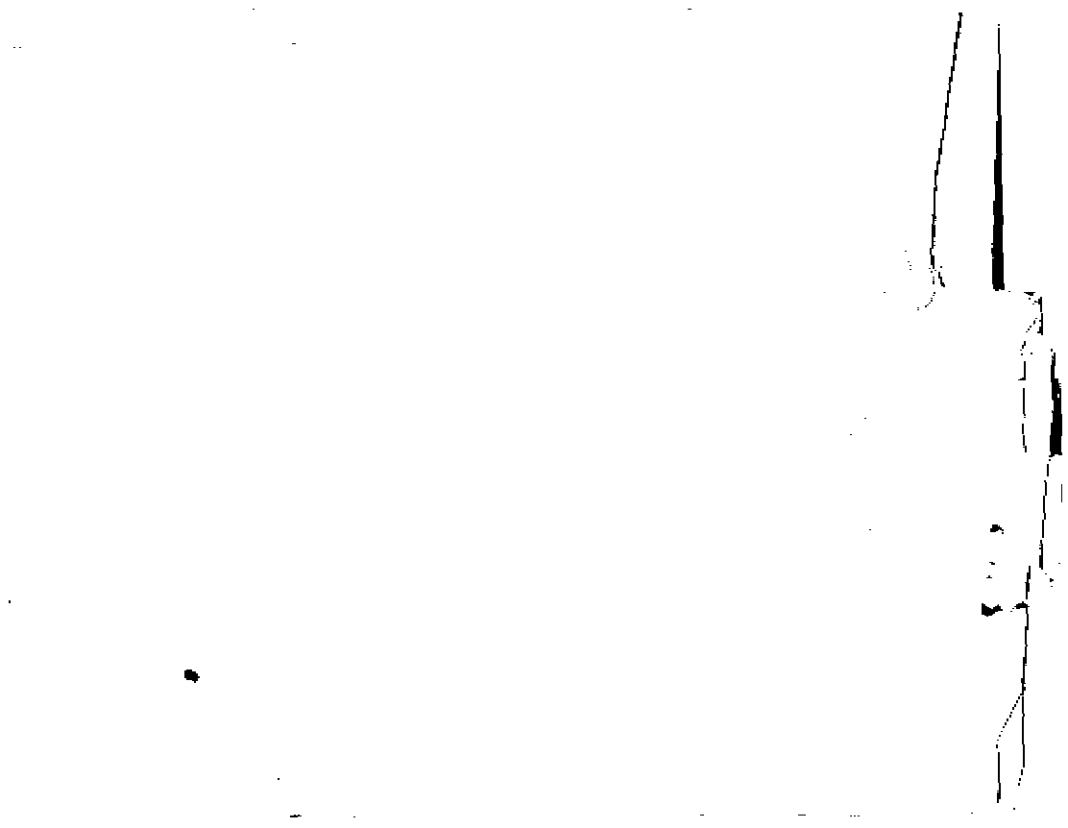

WATER SERVICE RECORD

Name **John E. Kelley Plumbing & Heating Co. (STATE ARMORY)**

Service No. **72**

Address **459 Bedford Street**

Location

~~Residential~~ **New Service** W.O. #**8090**

Comm 2-10-63


Date	Material	Amount	Total	Date	Amount
10-9-63	Labor	129.05		8-2-63	Deposit 500.00
	10% O.H.	12.91	141.96	2-10-64	Refund 333.04
2	hrs. Town Shovel @6.50		13.00		166.96
3	hrs. Trucking @3.00		9.00		
1	hr. Trailer @ 3.00		<u>3.00</u>		
	12"x6" T-S-G		<u>166.96</u>		
Applied to S.H. # 94					35.19

TOWN OF LEXINGTON — BOARD OF PUBLIC WORKS

WATER DIVISION

DATE

Sketch of Service Here

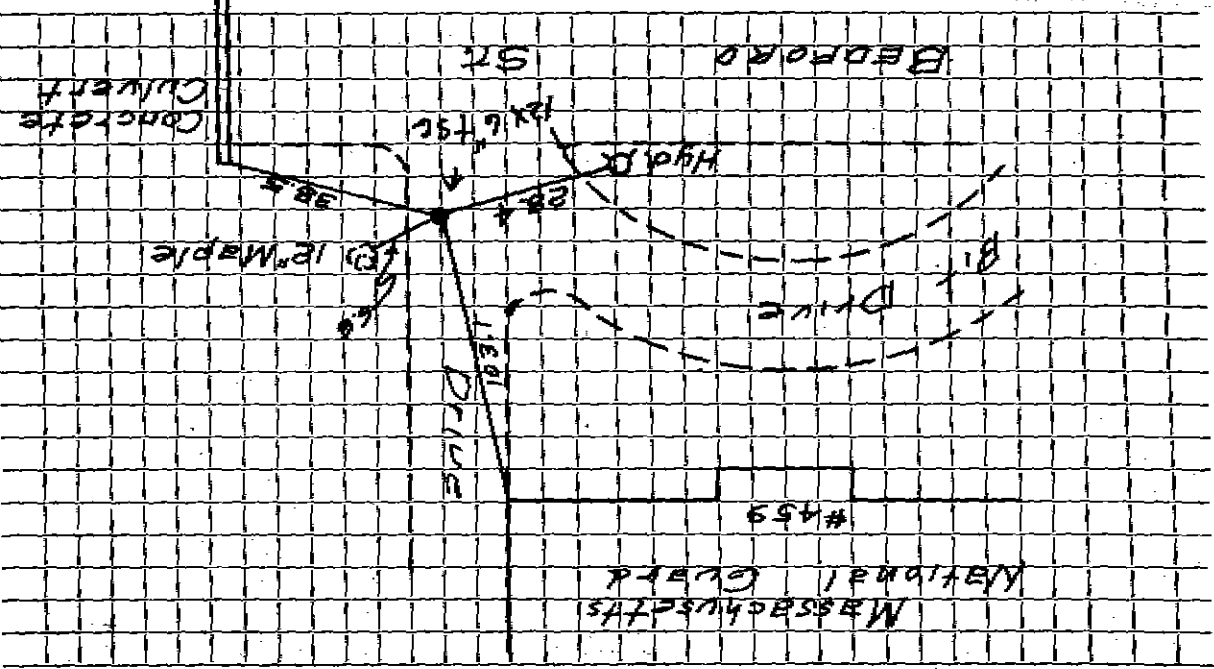

Street: Work completed

Connection made in

Remarks: