

## WATER SERVICE RECORD

Name Bilafer BrosService No. 15Address 46 Bedford Street GAS STA

Location

~~REWORK~~ New Service W.O. #8600


Imp 5/18/64

Date	Material	Amount	Total	Date	Amount
4-7-64	Labor	62 21		3-23-64	Deposit 300 00
	10% O.H.	6 02	66 23	5-18-64	Refund 114 71
136	1" Copper tubing @.56		76 16		185 29
1	1"X1" I.W.H. Stop & Waste		6 96		
3	1" 3 Part Unions @3.98		11 94		NON CHARGE
21	X 3 Patch		21 00	4-47-64	
1	H r. Trucking @3.00		3 00	18'	1" Copper tubing @.56 10 08
			185 29	1	1" C Corp Cock 7 31
				1	1" Curb Cock 8 06
				1	Box & Rod 4 90
				1	1" Offset tailpiece 50
				1	1" Straight tailiece 50
					47 66

DATE \_\_\_\_\_

TOWN OF LEXINGTON — BOARD OF PUBLIC WORKS

WATER DIVISION

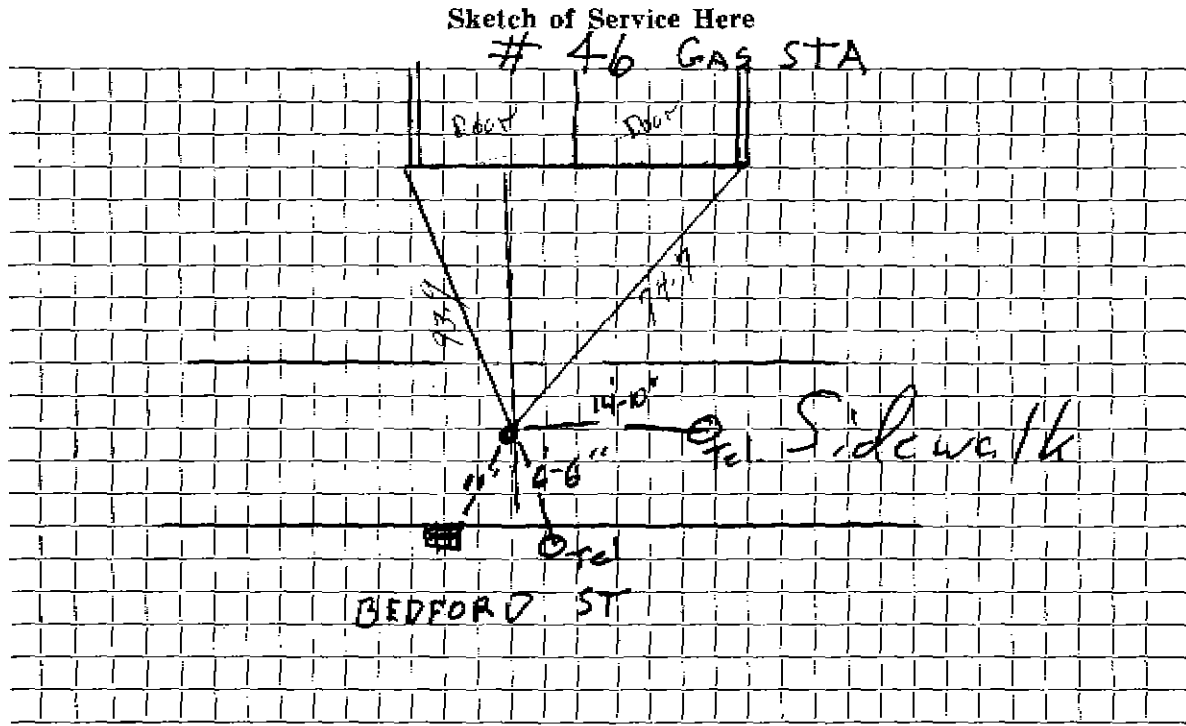

Connection made in ..... Street ..... Work completed .....

Remarks: .....

.....


.....



DATE 11-14-00

TOWN OF LEXINGTON — BOARD OF PUBLIC WORKS  
WATER DIVISION

Sketch of Service Here

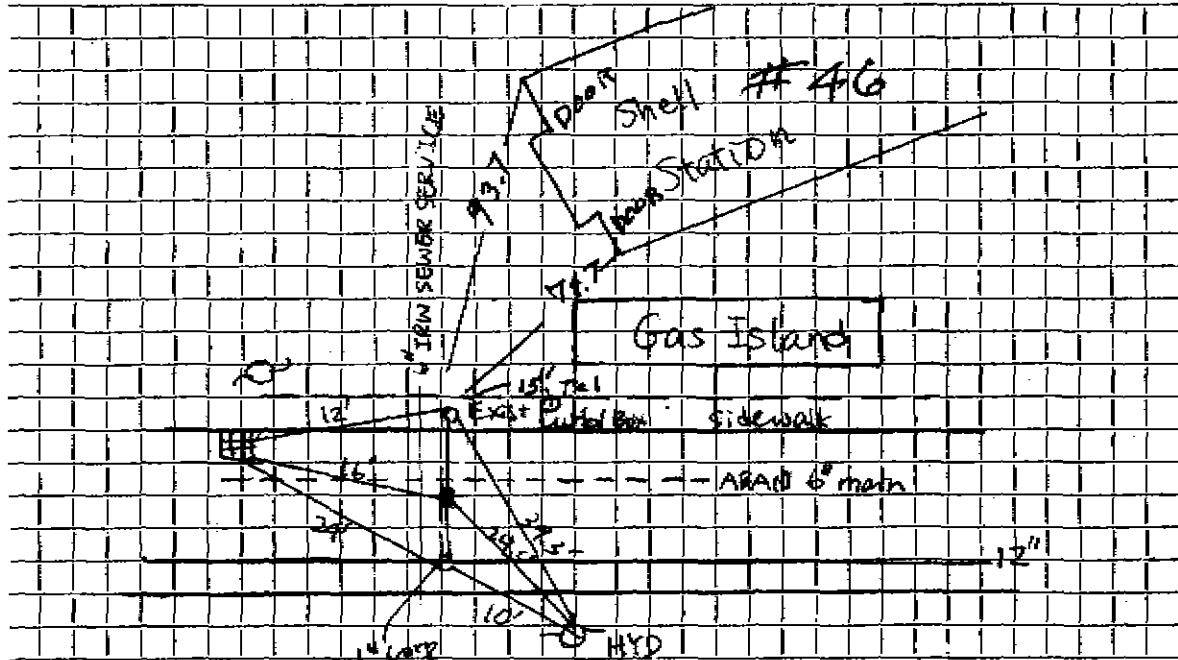

Connection made in ..... Street. Work completed .. Granese & Sons, Inc. (sub: Cont: dedelie)

Remarks: UNION DRAW 4:5 10/24/2000