

WATER SERVICE RECORD

Name John Graham

Service No. 201

Address 47 Bedford Street

9525

Location Lexington

~~Repair-Renewal~~ - New Service

Com. 9-29-52


Date	Material	Amount	Total	Date	Amount
9/10/52	Labor	1 63		9-10-52	20 00
	10% Overhead	16	1 79	9-29-52	19 46
	1 - 3/4" C x 1/2 I. W. H. stop & waste	4 00	4 00	<u>NON CHARGE</u>	
	1 hr. trucking		75	9/10/52	3 26
			6 54	10' - 3/4" Copper tubing @ .34	3 40
				1 - 3/4" C. corp-cock	4 33
				1 - 3/4" C x 3/4" C. curb-cock	4 67
	PIPE SUPPLIED & LAID BY OWNER			1 box and rod	3 90
	TRENCH DUG BY OWNER			1 - 1/2 offset tail piece	50
				1 - 1/2 straight tail piece	50
				1 hr. town shovel @ 5.00	5 00
				1 hr. trucking	75
					26 31
	<i>Killed 9T Curb 2-3/4" Copper Services</i>				
	<i>see tie on back</i>				
	<i>11-21-75</i>				

DATE _____

TOWN OF LEXINGTON — BOARD OF PUBLIC WORKS

WATER DIVISION

Sketch of Service Here

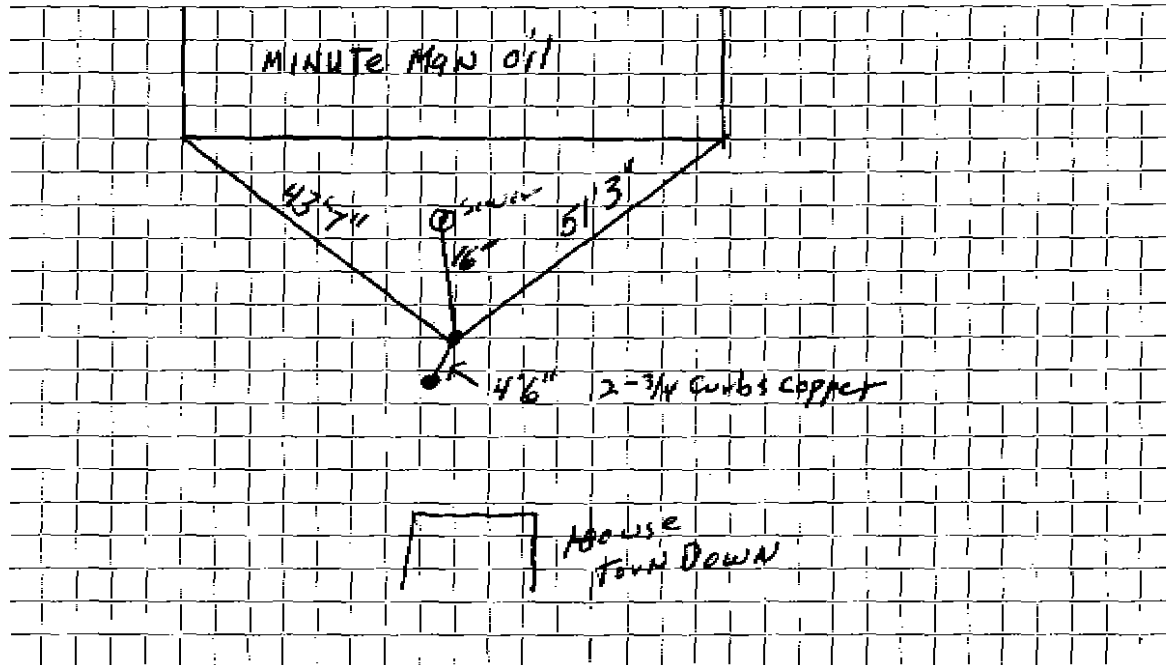

Connection made in Street. Work completed

Remarks:

.....

.....