

WATER SERVICE RECORD

Name

Service No.

Address 476 Bedford Street

Location

Repair—Renewal—New Service CHANGE SERVICE TO 12" MAIN W.O.#1542


Date	Material	Amount	Total	Date	Amount
7/12/54	INSIDE				
1	3/4 X 1" Union				
70'	3/4 3/4 COPPER				
1	3/4 X 1/2 S & W			Aug 27	
1	3/4 Union			Sep 1, 8, 60'	1" Copper
				Oct 5	1" Corp.
				Nov 5	3 length of 1 1/2" Black Iron SLEEVE
					1" Style 88
					1" Curb
					1 Box & Rod
					1 1" x 3/4" 3 part union
					2 6" Fenco Adapters
					26 yds. Gravel
					2 ton Cold Patch
					14 yds. Loam
					20 lbs. Grass Seed & 1 Bag Turf Food
					4 tons Hot Top
					29 1/2 hrs. Trucking
					24 hrs. Town Shovel
					3 hrs. Loader
					2 hrs. Roller

DATE _____

TOWN OF LEXINGTON — BOARD OF PUBLIC WORKS

WATER DIVISION

Sketch of Service Here

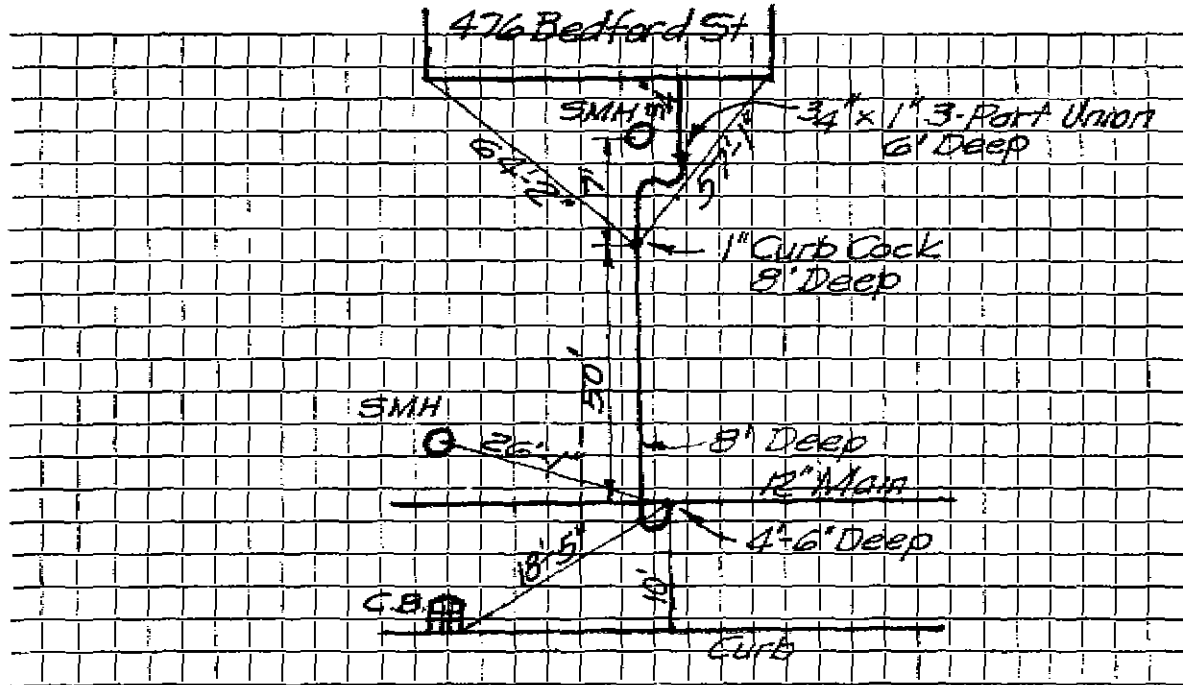

Connection made in _____ Street. Work completed _____

Remarks: 1" COPPER INSIDE OF 1/2" BLACK IRON