


TOWN OF LEXINGTON — BOARD OF PUBLIC WORKS
 WATER DIVISION
 DATE _____

Sketch of Service Here

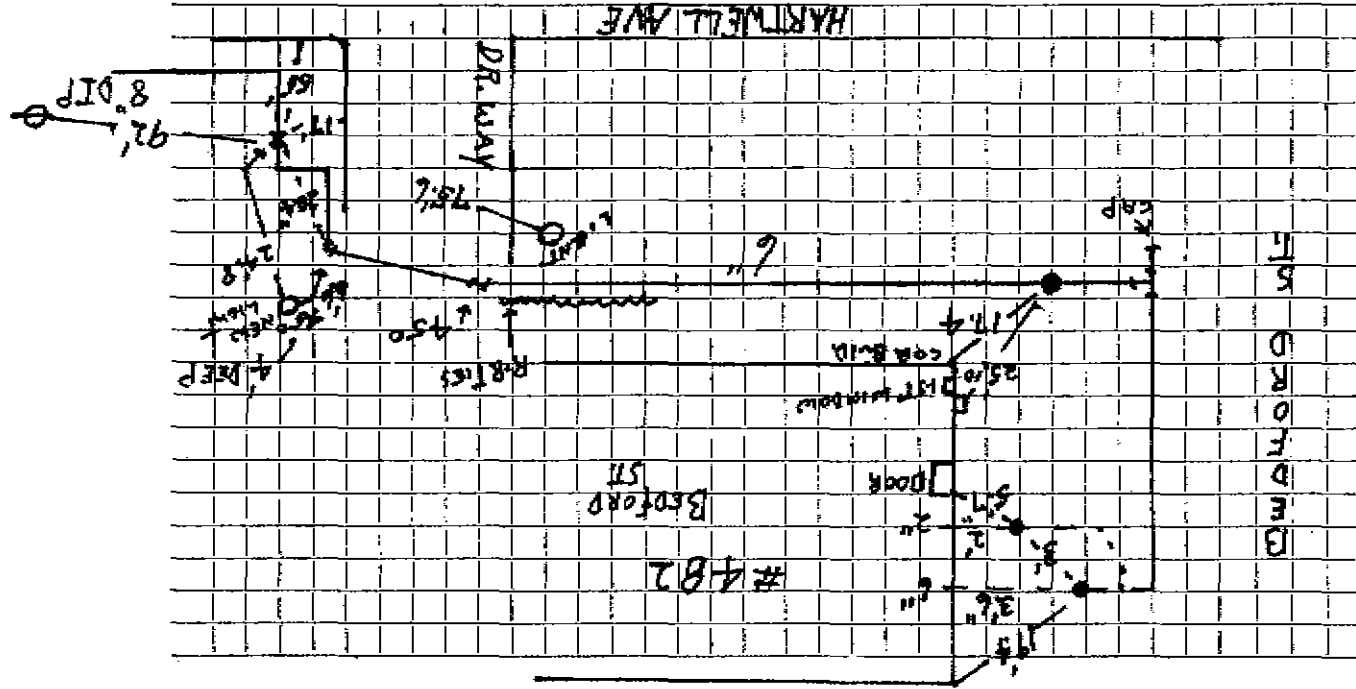

Connection made in _____ Street, _____ Work completed _____

Remarks: _____