

Name Nils Anderson

Service No. 18 3081

Address 901 Mass. Avenue  
# 491 Bedford St.  
Arlington, Mass.

Location <sup>491</sup> Bedford Street

Kind of Pipe

Size

Size of Main

~~Repair~~ ~~Renewal~~ ~~New Service~~

Location

Date

Material

Amount

Total

Date

Amount

Nov. 11, '44

Labor 6 60  
10% Overhead  
357' 1" C.L. Pipe @.25  
17 Couplings @.21  
1 " L Union  
Trucking 2 hrs. @.75  
Patching

6 60  
66  
89 25  
3 57  
67  
1 50  
33 34  
135 59

Sept 20 44

Deposited  
Non-Charge  
1 - 1" C. Corp-cock  
55' - 1" Copper Tubing  
1 - 1" C x 1" I Curb-cock  
2' - 1" C.L. Pipe  
1 - Box & Rod  
1 - Pit Cover & Frame  
5' - 34" Cement Pipe  
2 - 1" Straight Tail Pieces  
Trucking 2 hrs.  
Comp. 2 hrs.

200 00

Labor

Dec. 31 44

Refunded

64 41  
135 59

DATE \_\_\_\_\_

# TOWN OF LEXINGTON—BOARD OF PUBLIC WORKS

## WATER DIVISION

The undersigned applies for a supply of water at No. \_\_\_\_\_ St. and hereby agrees to comply with the rules and regulations as now, or at any future time, established by the Board of Selectmen.

Am't. of Estimate \$ \_\_\_\_\_


Owner \_\_\_\_\_

Am't. Paid \$ \_\_\_\_\_

Address \_\_\_\_\_

Builder \_\_\_\_\_

Sketch of Service Here

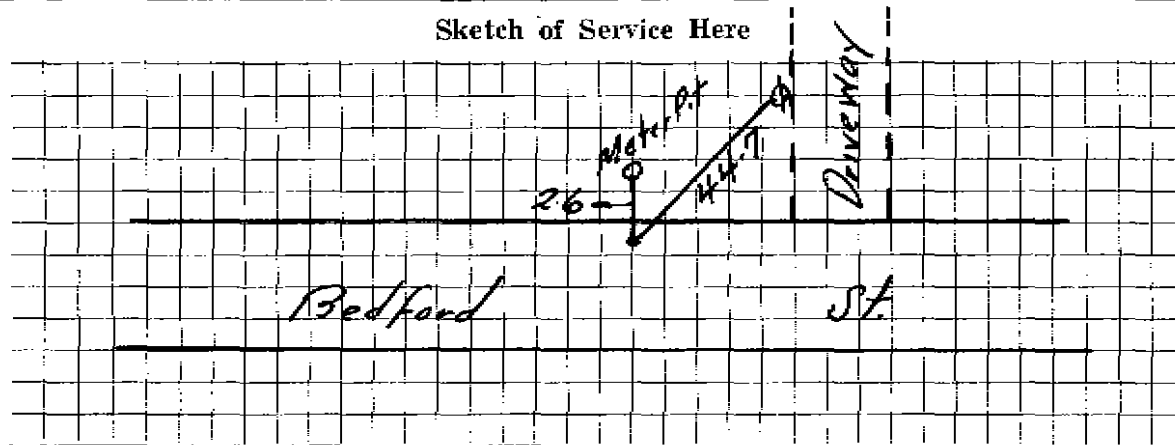

Connection made in \_\_\_\_\_ Street. Work completed \_\_\_\_\_ 19 \_\_\_\_\_

Remarks: