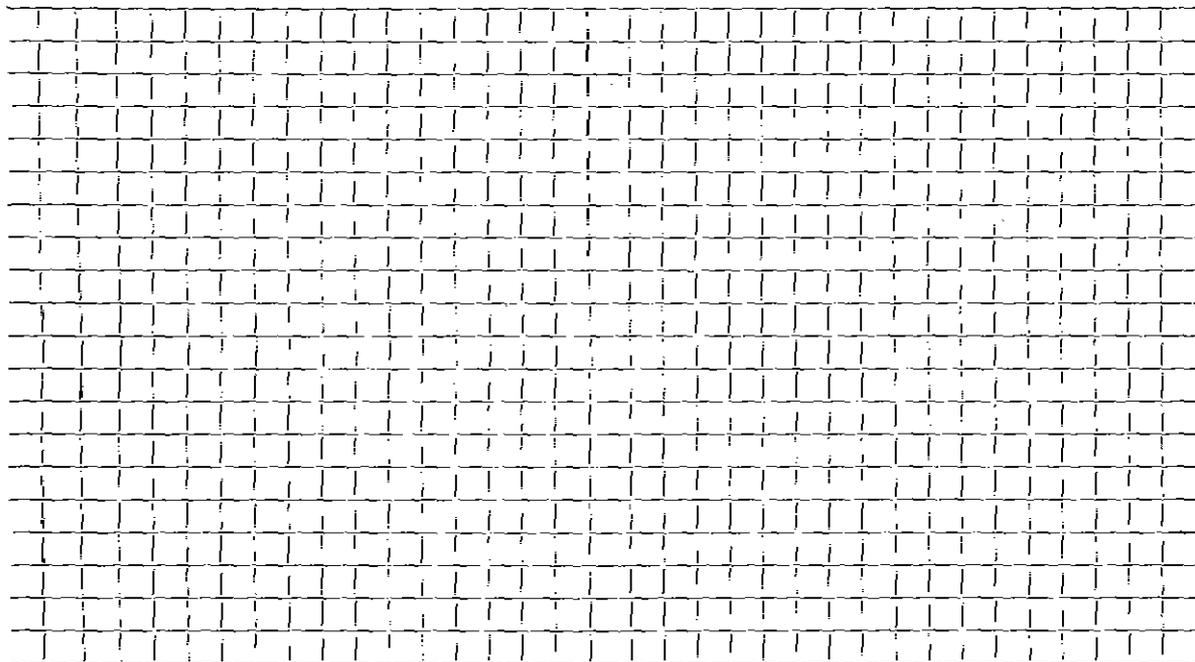


DATE _____

TOWN OF LEXINGTON — BOARD OF PUBLIC WORKS

WATER DIVISION

Sketch of Service Here

A large grid of graph paper, consisting of approximately 20 columns and 25 rows of small squares, intended for sketching service details.

Connection made in Street. Work completed

Remarks:
.....
.....