


DATE Sept 18 1997

TOWN OF LEXINGTON — BOARD OF PUBLIC WORKS

WATER DIVISION

Sketch of Service Here

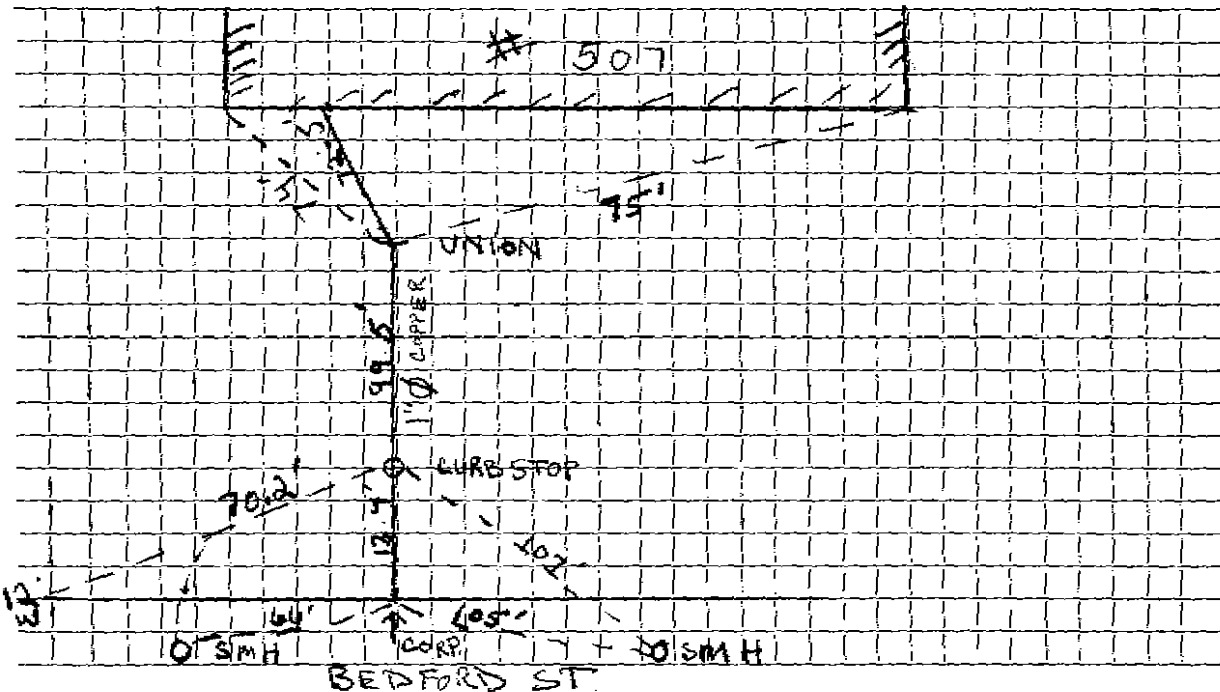

Connection made in Street. Work completed


Remarks:

BOOK 97-3

DATE SEPT 17 1997

TOWN OF LEXINGTON — BOARD OF PUBLIC WORKS
WATER DIVISION

Sketch of Service Here

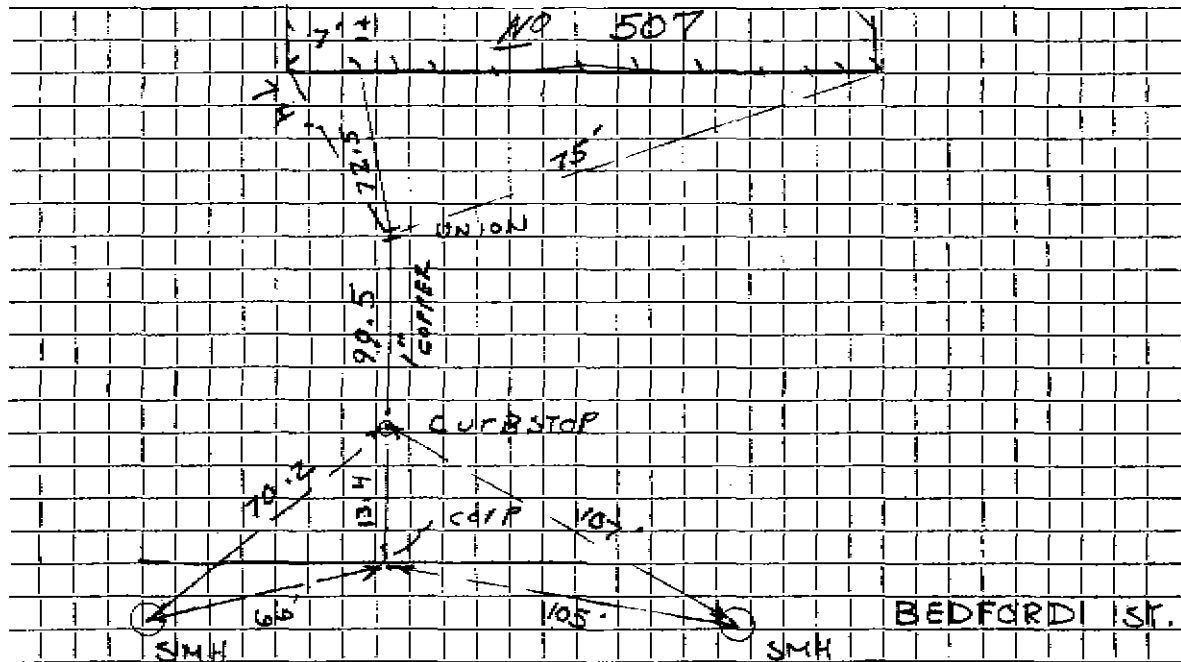

Connection made in BEDFORD..... Street.

Work completed G.W. GATLEY, INC.....

Remarks:

.....


.....

DATE Sept 18 1997

TOWN OF LEXINGTON — BOARD OF PUBLIC WORKS

WATER DIVISION

Sketch of Service Here

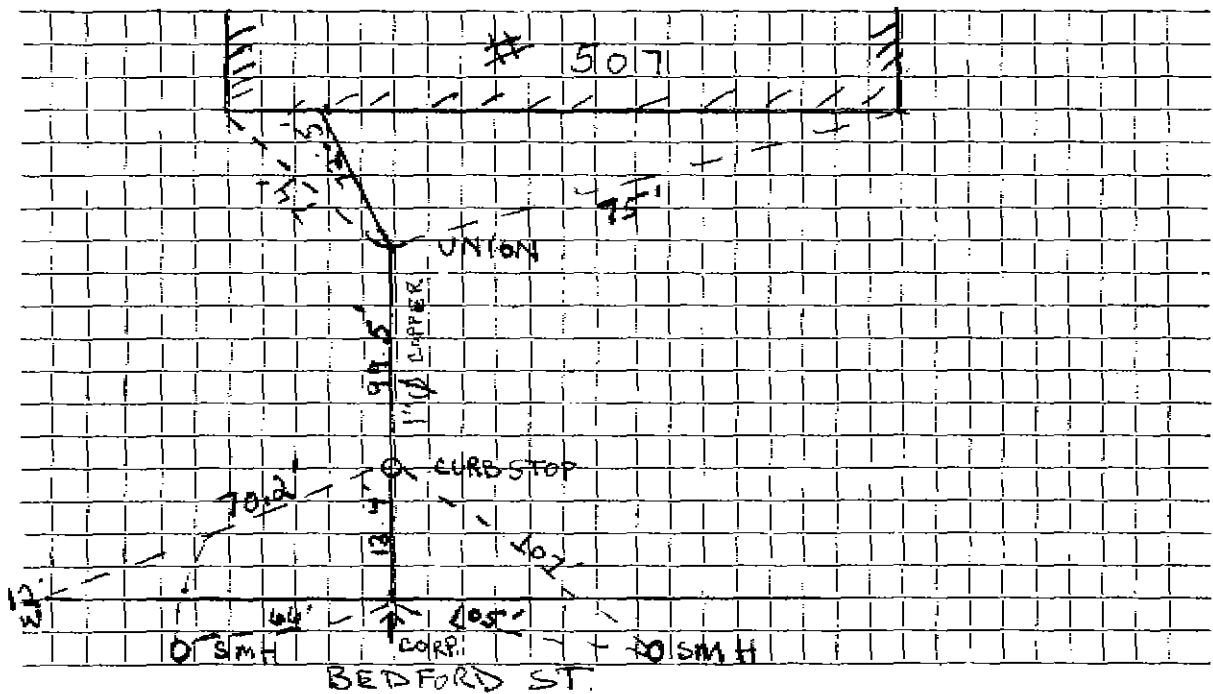

Connection made in Street. Work completed

Remarks:

Book 97-3