

WATER SERVICE RECORD

Name

Service No.

Address 509 BEDFORD ST.

Location


Repair—Renewal—New Service Contract 91-10 C. J. Parsons

Date	OUTSIDE Material	Amount	Total	Date	Amount
9-25-92	8.4 LF 1" COPPER				
	1" COP				
	1" CURB				
				12-8-88	Service To house
					159' 1" Copper
					1 1/2" Curb Cock
					1 Box

DATE _____

TOWN OF LEXINGTON — BOARD OF PUBLIC WORKS
WATER DIVISION

Sketch of Service Here

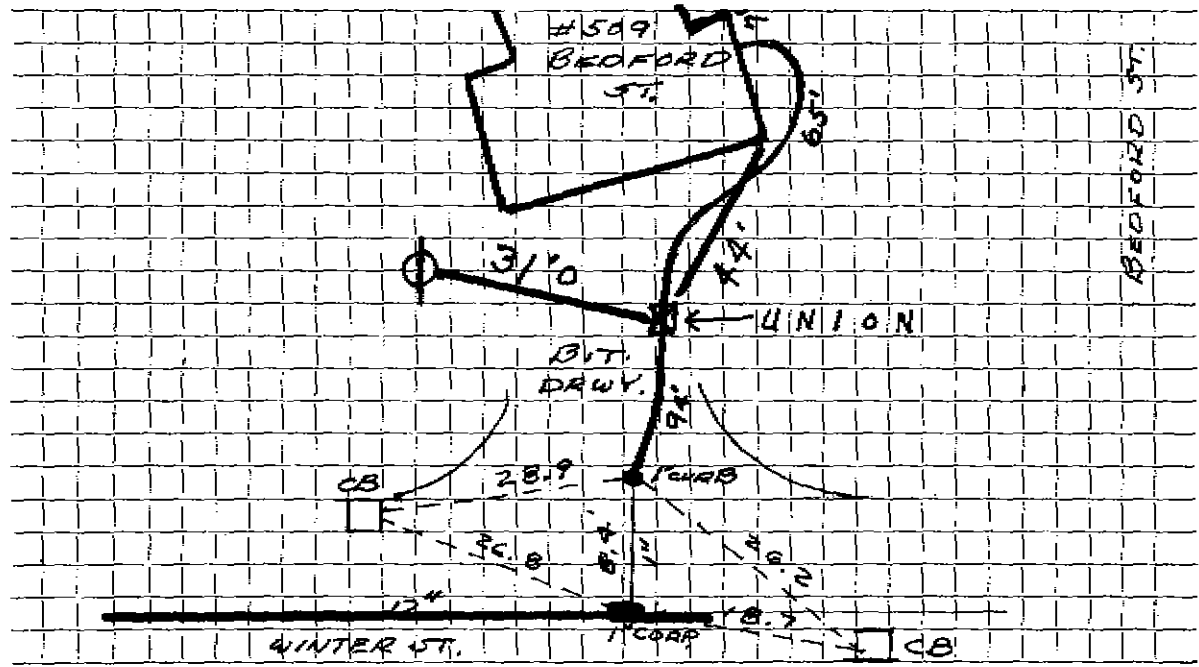

Connection made in WINTER Street. Work completed

Remarks:
.....
.....