

Name K. V. Wolsey Company

Service No.

#4345
#6896
#7120

Address 517 Bedford Street

Lexington, Mass.

Location 517 Bedford Street

Kind of Pipe

Size

Size of Main

~~Renewal~~ New Service

Com. 9-26-49

Location

Date	Material	Amount	Total	Date	Amount
Jul. 18, '49	Labor	4 20	4 20	July 11, '49	40 00
	10% Overhead		42		
	1 - 3/4" C x 1/2" I.W.H. S&W		3 29		
	Trucking 1 hr. @.75		75	Jul. 18, '49	18 50
	Patching 32 x 3		32 00		
			40 66	45' - 3/4" Copper Tubing @.24	10 80
				1 - 3/4" C Corp-cock	3 15
				1 - 3/4" C x 3/4" C Curb-cock	3 85
				1 - Box & Rod	3 95
				1 - 1/2" Offset Tail Piece	37
				1 - 1/8" Straight Tail Piece	37
				Littlefield Shovel 3 hrs. @7.00	21 00
				Compressor 1 hr. @ 1.75	1 75
				Trucking 1 hr. @.75	75
	Labor				64 49

Deposited

No Charge

DATE _____

TOWN OF LEXINGTON - BOARD OF PUBLIC WORKS

WATER DIVISION

The undersigned applies for a supply of water at No..... St. and hereby agrees to comply with the rules and regulations as now, or at any future time, established by the Board of Selectmen.

Am't of Estimate \$.....

Owner


Am't Paid \$.....

Address

Builder

.....

Sketch of Service Here

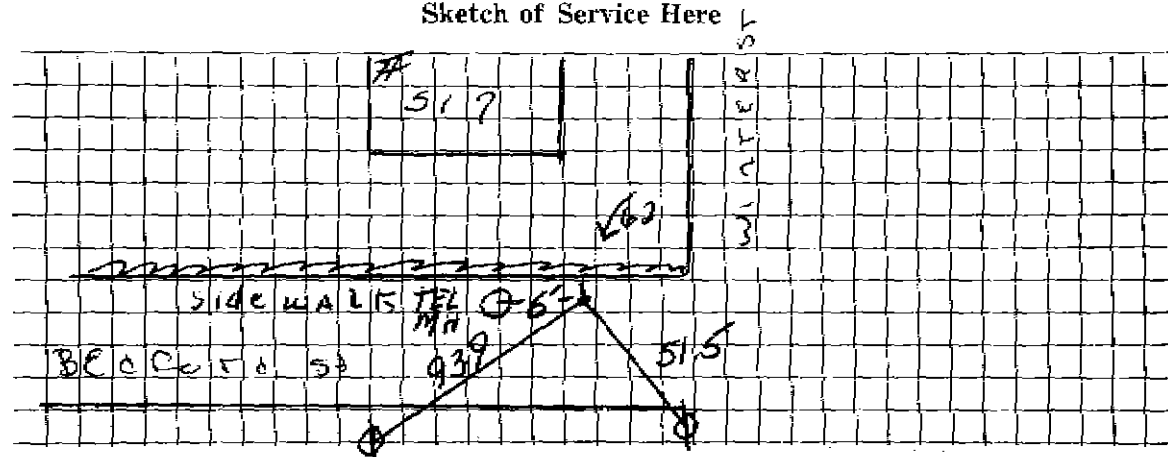

Connection made in Street.

Work completed19

Remarks: