


TOWN OF LEXINGTON - BOARD OF PUBLIC WORKS
WATER DIVISION

SKETCH OF SERVICE HERE

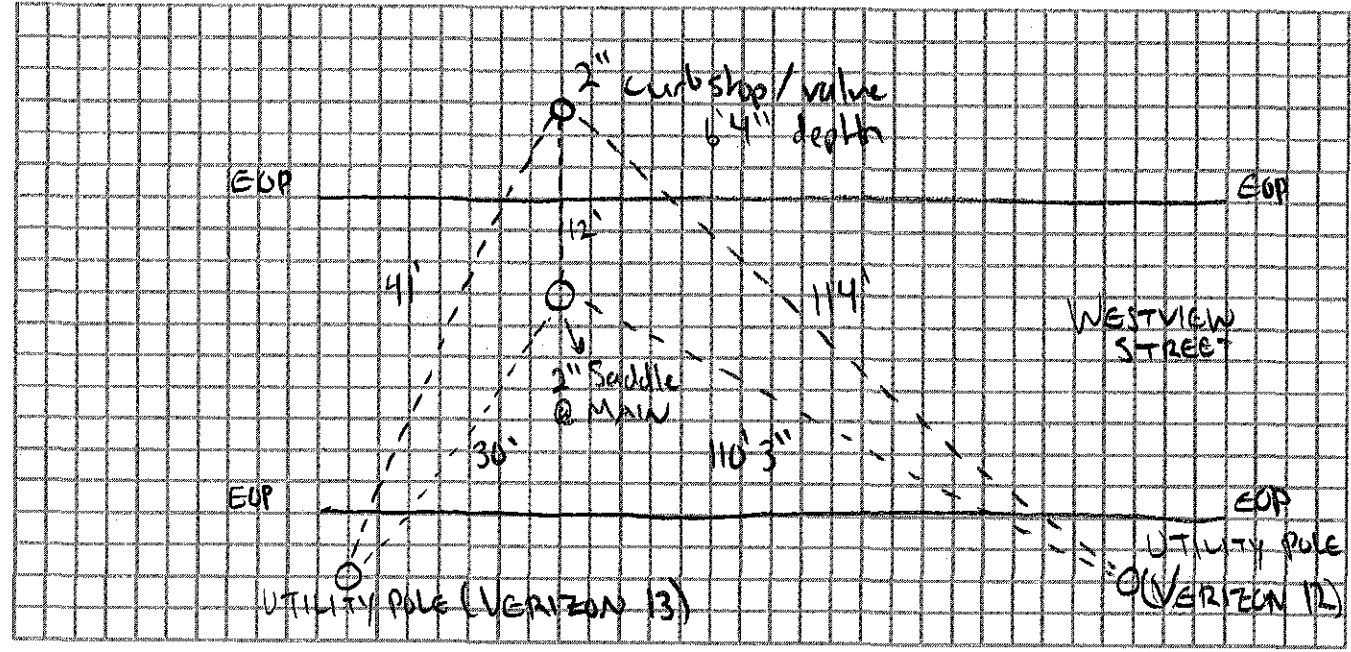

Connection made in: Westview St Street. Work completed:

Remarks: INSTALLED BY UEL CONTRACTORS