

Name K. V. Wolsey Company

2033 Service No. #371

Address 521 Bedford Street

Lexington, Mass.

Location 521 Bedford Street

Kind of Pipe

Size

Size of Main

~~REPAIR~~ New Service

Com. 8-15-49

Location

Date	Material	Amount	Total	Date	Amount
June 30, '49	Labor	6 95	6 95	July 11, '49	40 00
	10% Overhead		70	Aug 3, '49	6 57
	12' - 3/4" Copper Tubing @.24		2 88		46 57
	1 - 3/4" C x 1/2" I.W.H. S&W		3 29	June 17, '49	24 20
	Trucking 1 hr. @.75		75	June 30, '49	11 96
	Patching 32 x 3		32 00	45' - 3/4" Copper Tubing @.24	10 80
			46 57	1 - 3/4" C Corp-cock	3 15
				1 - 3/4" C x 3/4" Curb-cock	3 85
				1 - Box & Rod	3 95
				1 - 1/2" Offset Tail Piece	37
				1 - 1/2" Straight Tail Piede	37
				Littlefield Shovel 2 hrs. @ 7.00	14 00
	Labor			Compressor 4 hrs. @ 1.75	7 00
				Trucking 1 hr. @.75	75
				REPAIR - 10/22/51	80 40
				16' COPPER	
				2 3/4 UNIONS	

TOWN OF LEXINGTON - BOARD OF PUBLIC WORKS
WATER DIVISION

The undersigned applies for a supply of water at No. St. and hereby agrees to comply with the rules and regulations as now, or at any future time, established by the Board of Selectmen.

Am't of Estimate \$.....


Owner

Am't Paid \$.....

Address

Builder

Sketch of Service Here

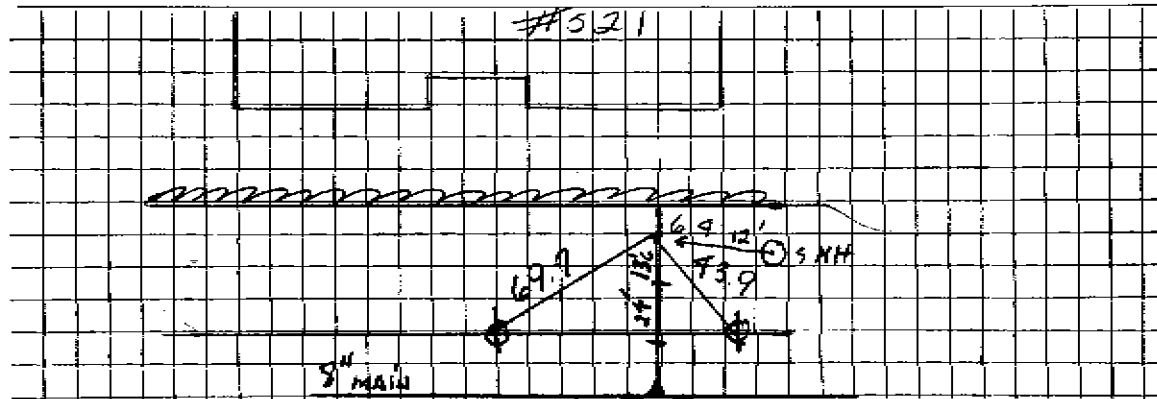

Connection made in 4105 - 15' Street. 51' - 6104 Work completed19

Remarks: