

Name K. V. Wolsey

Service No. 26

Address 527 Bedford Street

Location 527 Bedford Street

Kind of Pipe

Size

Size of Main

~~Repair or Renewal~~ New Service

Com. 8-15-49

Location

Date	Material	Amount	Total	Date	Amount
June 30, '49	Labor	6 95	6 95	June 7, '49	Deposited
	10% Overhead		70	Oct 3, '49	Paid
	12' - 3/4" Copper Tubing @.24	2 88			Non-Charge
	1 - 3/4" C x 1/2" I.W.H. S&W	3 29		June 17, '49	Labor
	Trucking 1 hr. @.75	75		June 30, '49	Labor
	Patching 32 x 3		32 00		38' - 3/4" Copper Tubing @.24
			46 57		1 - 3/4" C Corp-cock
					1 - 3/4" C x 3/4" C Curb-cock
					1 - Box & Rod
					1 - 1/2" Offset Tail Piece
					1 - 1/2" Straight Tail Piece
					Compressor 4 hrs. @1.75
	Labor				Littlefield Shovel 2 hrs. @7.00
					Trucking 1 hr. @.75
					<u>71 77</u>

TOWN OF LEXINGTON – BOARD OF PUBLIC WORKS

WATER DIVISION

The undersigned applies for a supply of water at No..... St. and hereby agrees to comply with the rules and regulations as now, or at any future time, established by the Board of Selectmen.

Am't of Estimate \$.....


Owner

Am't Paid \$.....

Address

Builder

Sketch of Service Here

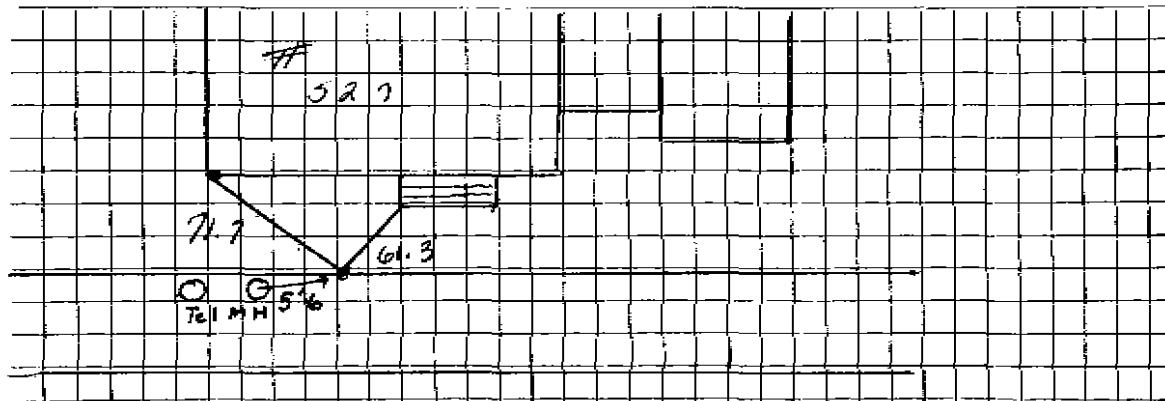

Connection made in Street.

Work completed19

Remarks: