

**WATER SERVICE RECORD**

Name A. & D Realty Service No. 36  
Address 53 Bedford Street  
Location 6" x 12" Tapping Sleeve & Gate  
~~Request~~ Request New Service W.O. #5 DeFlie #3358

DEC 26 1978


Date	Material	Amount	Total	Date		Amount
11-8-78	Labor	123.25		10-10-78	Deposit	400.00
	Police	45.50	168.75	8-24-79	Paid	25.00
	10% O.H.		16.88			445.78
	4 yds. Gravel @2.44		9.76			
	1 ton Cold Patch		14.75			
	1½ hrs. Trucking @3.00		4.50			
	3 hrs. Backhoe @6.50		19.50			
	1 hr. Compressor		5.00			
	Hot Top Sidewalk 27' x 7'		126.00			
	Hot Top Street 11' x 11'		80.64			
			445.78			
11-22-78	9' 1" Copper tubing					

DATE \_\_\_\_\_

TOWN OF LEXINGTON — BOARD OF PUBLIC WORKS

**WATER DIVISION**

Sketch of Service Here

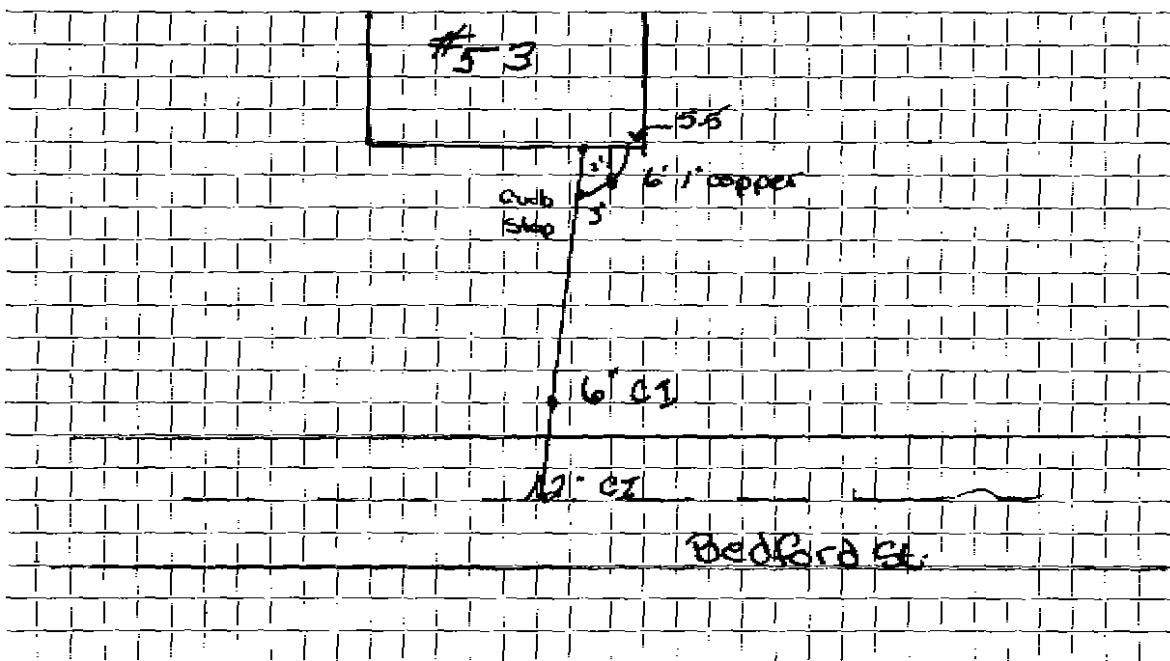

Connection made in ..... Street. Work completed .....

Remarks: .....