

Name K. V. Wolsey
Address 533 Bedford Street

Service No. 76 #1885

Location 533 Bedford Street

Kind of Pipe Size Size of Main
~~Repair/Revised~~—New Service Com. 8-15-49 Location

Date	Material	Amount	Total	Date	Amount	
June 30, '49	Labor	6 95	6 95	June 7, '49	Deposited	\$0 00
	10% Overhead		70	Oct 3, '49	Card	6 57
	12' - 3/4" Copper Tubing @.24	2 88			Non-Charge	46 57
	1 - 3/4" C x 1/2" I.W.H. S&W	3 29		June 16, '49	Labor	14 94
	Trucking 1 hr. @.75		75	June 30, '49	Labor	5 01
	Patching 32 x 3		32 00		38' - 3/4" Copper Tubing @.24	9 12
			46 57		1 - 3/4" C Corp-cock	3 15
					1 - 3/4" C x 3/4" C Curb-cock	3 85
					1 - Box & Rod	3 95
					1 - 1/2" Offset Tail Piece	37
					1 - 1/2" Straight Tail Piece	37
					Littlefield Shovel 2 hrs. @7.00	14 00
	Labor				Compressor 4 hrs. @1.75	7 00
					Trucking 1 hr. @.75	75
						62 51

TOWN OF LEXINGTON - BOARD OF PUBLIC WORKS

WATER DIVISION

The undersigned applies for a supply of water at No..... St. and hereby agrees to comply with the rules and regulations as now, or at any future time, established by the Board of Selectmen.

Am't of Estimate \$.....

Owner


Am't Paid \$.....

Address

Builder

.....

Sketch of Service Here

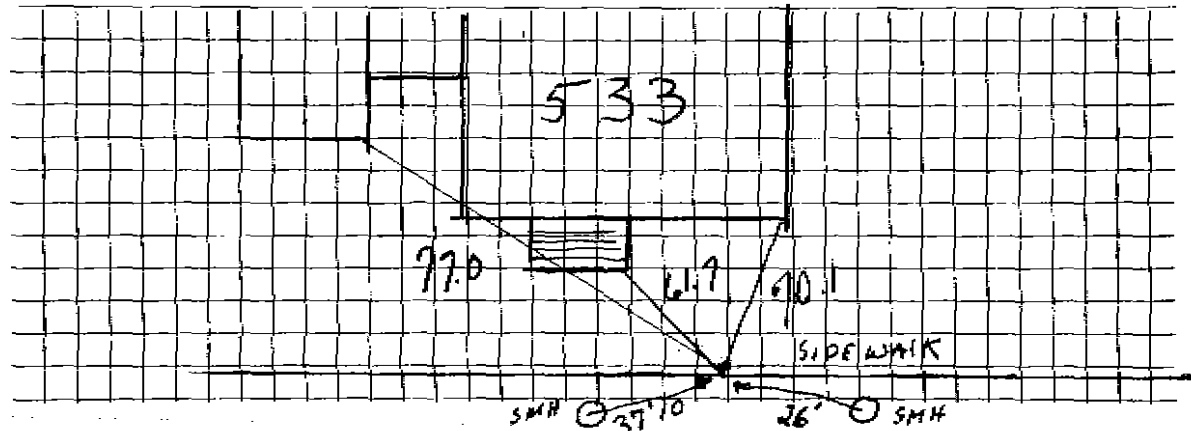

Connection made in Street. Work completed19

Remarks:
