

Name K. V. Wolsey Company

2279 Service No.

2

Address 537 Bedford Street

#273

Lexington, Mass.

Location 537 Bedford Street

Kind of Pipe

Size

Size of Main

~~Repair~~ ~~XXXXXX~~ New Service

Com. 8-15-49

Location

Date	Material	Amount	Total	Date	Amount
June 30, '49	Labor	6 95	6 95	July 11, '49	40 00
	10% Overhead		70	Oct 3, '49	6 57
	12' - 3/4" Copper Tubing @ .24		2 88		46 57
	1 - 3/4" C x 1/2" I.W.H. S&W		3 29	June 16, '49	20 70
	Trucking 1 hr. @ .75		75	June 30, '49	4 01
	Patching 32 x 3		32 00	38' - 3/4" Copper Tubing @ .24	9 12
			46 57	1 - 3/4" C Corp-cock	3 15
				1 - 3/4" C x 3/4" C Curb-cock	3 85
				1 - 3/4" C x 3/4" C Union (3pts)	1 39
				1 - Box & Rod	3 95
				1 - 1/2" Offset Tail Piece	37
				1 - 1/2" Straight Tail Piece	37
	Labor			Littlefield Shovel 2 hrs. @ 7.00	14 00
				Compressor 4 hrs. @ 1.75	7 00
				Trucking 1 hr. @ .75	75
					68 66

Deposited
Card
Non-Charge

DATE _____

TOWN OF LEXINGTON - BOARD OF PUBLIC WORKS

WATER DIVISION

The undersigned applies for a supply of water at No. St. and hereby agrees to comply with the rules and regulations as now, or at any future time, established by the Board of Selectmen.

Am't of Estimate \$.....

Owner


Am't Paid \$.....

Address

Builder

.....

Sketch of Service Here

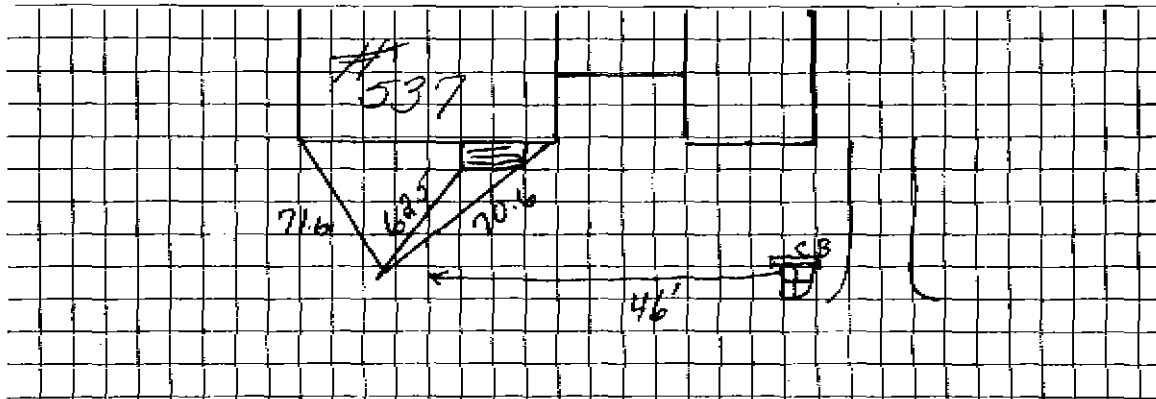

Connection made in Street.

Work completed19

Remarks: