

Name K. V. Wolsey
 Address 541 Bedford Street

Service No. 130

Location 541 Bedford Street

Kind of Pipe Size Size of Main
~~Repair - Renewal~~ New Service Com. 8-15-49 Location

Date	Material	Amount	Total	Date	Amount
June 30, '49	Labor	6 95	6 95	July 11, '49 Deposited	40 00
	10% Overhead	70	70	Oct 3, '49 Paid	6 57
	12' - 3/4" Copper Tubing @.24	2 88	2 88		46 57
	1 - 3/4" C x 1/2" I.W.H. S&W	3 29	3 29	June 15, '49 Labor	4 40
	Trucking 1 hr.	75	75	June 16, '49 Labor	12 46
	Patching 32 x 3	32 00	32 00	June 30, '49 Labor	5 01
			46 57	38' - 3/4" Copper Tubing @.24	9 12
				1 - 3/4" C Corp-cock	3 15
				1 - 3/4" C x 3/4" C Curb-cock	3 85
				1 - Box & Rod	3 95
				1 - 1/2" Offset Tail Piece	37
				1 - 1/2" Straight Tail Piece	37
	Labor			Compressor 4 hrs. @1.75	7 00
				Littlefield Shovel 2 hrs. @7.00	14 00
				Trucking 1 hr.	75
					64 43

TOWN OF LEXINGTON - BOARD OF PUBLIC WORKS

WATER DIVISION

The undersigned applies for a supply of water at No..... St. and hereby agrees to comply with the rules and regulations as now, or at any future time, established by the Board of Selectmen.

Am't of Estimate \$.....


Owner

Am't Paid \$.....

Address

Builder

Sketch of Service Here

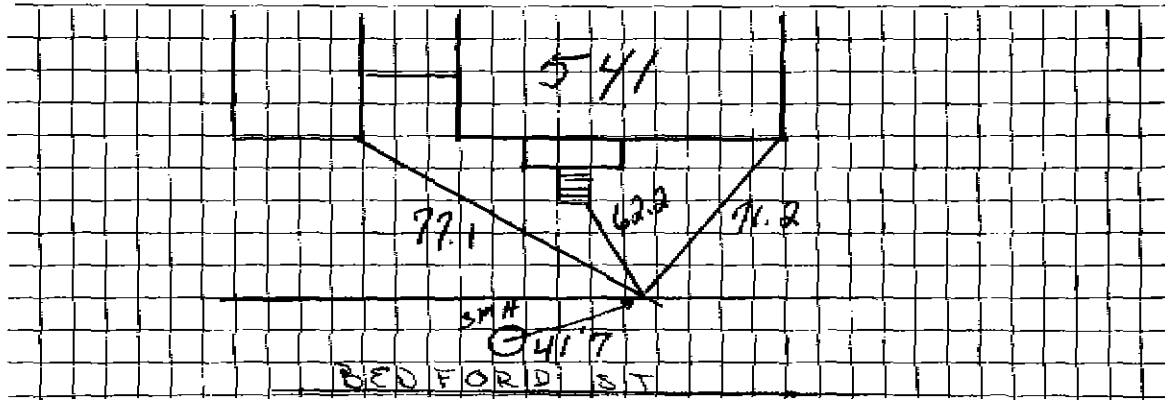

Connection made in Street.

Work completed19

Remarks: