

WATER SERVICE RECORD

Name

Service No.

Address

560 Belford St

Location


Repair—Renewal—New Service

Date	Material	Amount	Total	Date	Amount
					Inside
				12-30-94	78'-8" 1 copper
					3 3 part unions 1"
					plus ? 1 copper already installed by builder

DATE \_\_\_\_\_

TOWN OF LEXINGTON — BOARD OF PUBLIC WORKS

WATER DIVISION

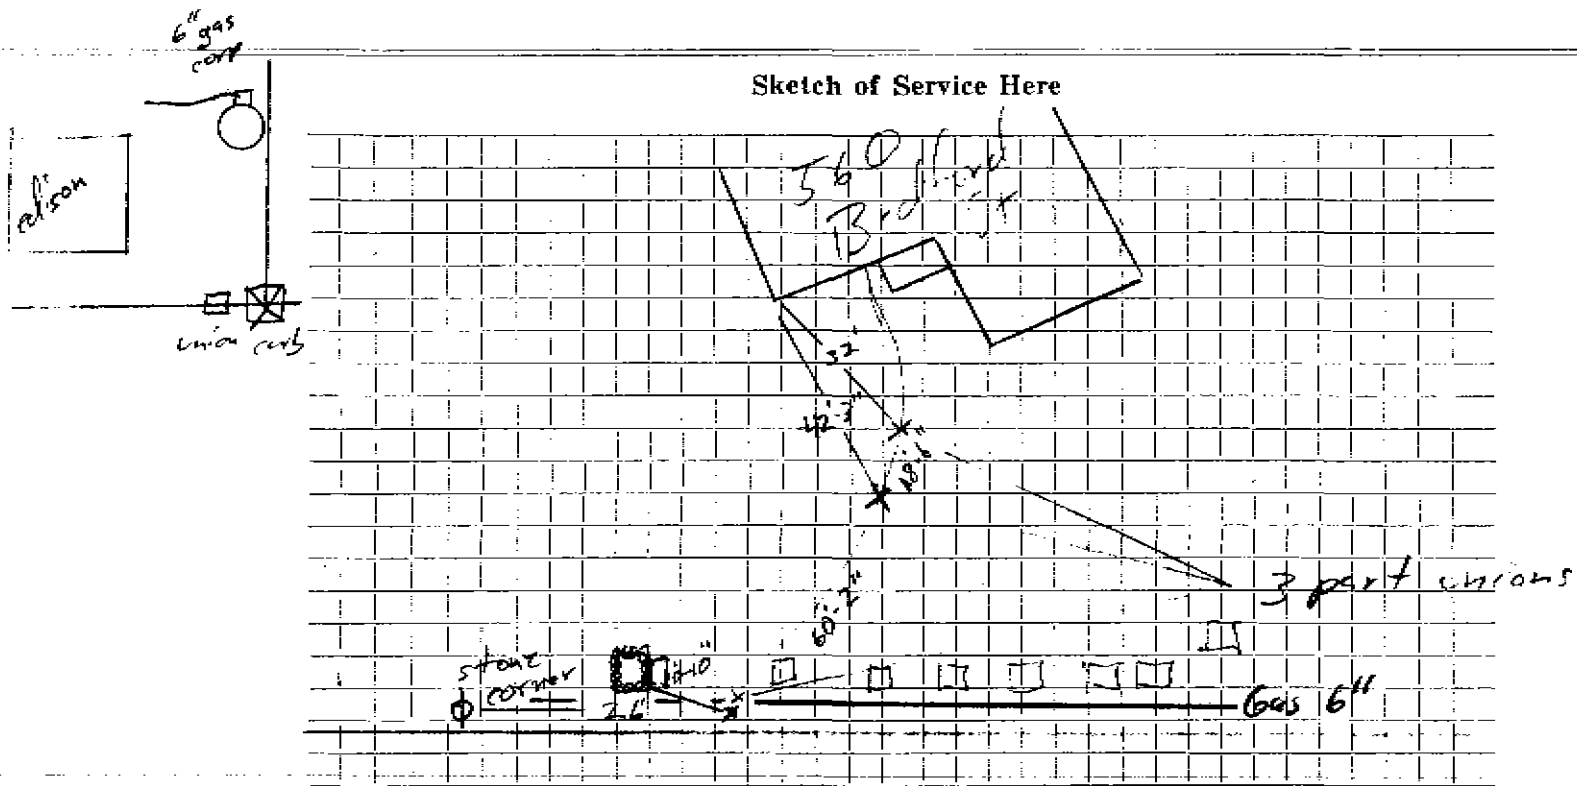

Connection made in Bredford St Street. Work completed .....

Remarks: .....