




DATE \_\_\_\_\_

TOWN OF LEXINGTON — BOARD OF PUBLIC WORKS

WATER DIVISION

Sketch of Service Here

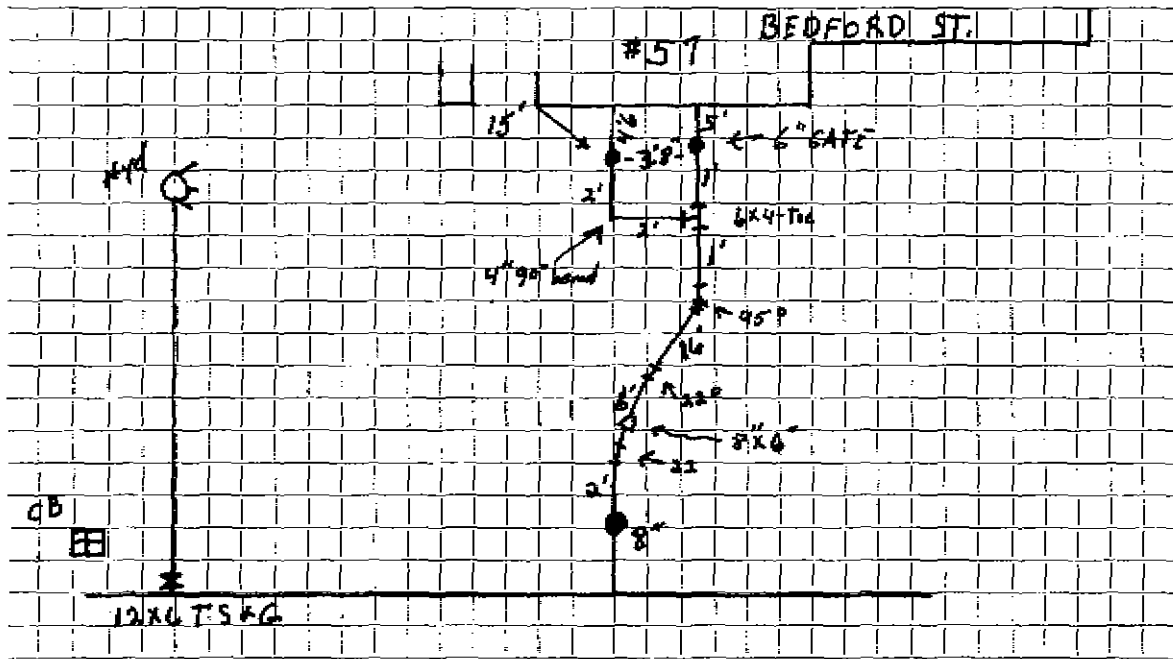

Connection made in ..... "Hyd" ..... Street. Work completed .....

Remarks: USED EXISTING 8" Feed For Sprinkler .....

## WATER SERVICE RECORD

Name

Service No.

Address

57 Bedford Street

Location

~~Repair~~ ~~Renewal~~ ~~New Service~~

Date	Material	Amount	Total	Date	Material	Amount
					<b>NON CHARGE</b>	
				6/3/68	Labor	33 66
				8'	1" Copper tubing @ .56	4 48
				1	1" C. Corp Cock	7 31
				1	1" C. Curb Cock	8 06
				1	Box & Rod	4 90
					8x3 Patch	8 00
				2	hrs. Town Shovel @ 6.50-13	13 00
				2	hrs. Trucking @ 3.00	6 00
						<u>85 41</u>


DATE \_\_\_\_\_

# TOWN OF LEXINGTON — BOARD OF PUBLIC WORKS

## WATER DIVISION

Sketch of Service Here

#57

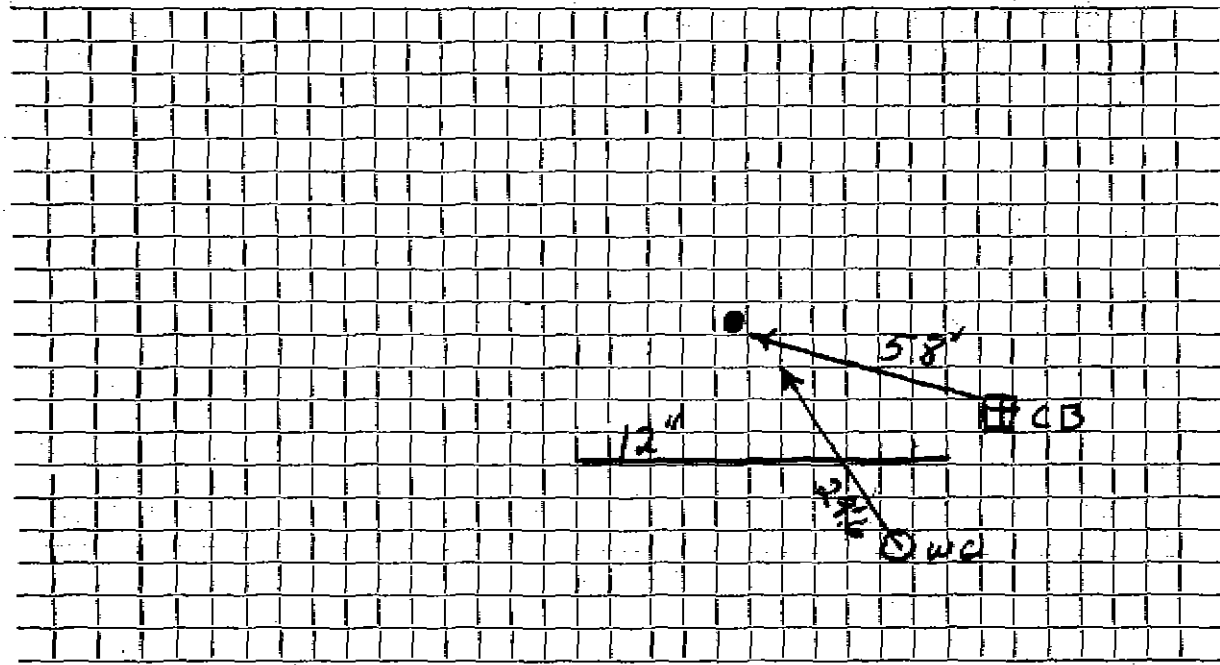

Connection made in ..... Street. Work completed .....

Remarks: .....  
.....  
.....