




DATE \_\_\_\_\_

# TOWN OF LEXINGTON — BOARD OF PUBLIC WORKS

## WATER DIVISION

Sketch of Service Here

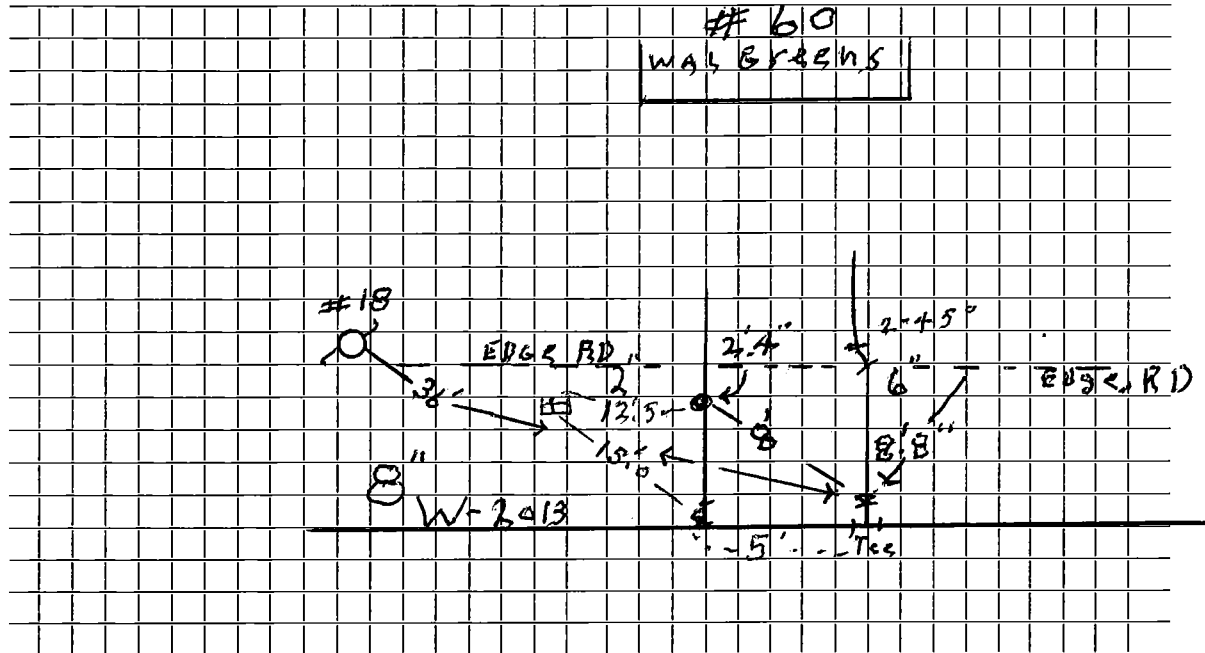

Connection made in Bedford ST Street. Work completed Cedrone/2013

Remarks: # T.P. 18 To 6" gate 36'