

WATER SERVICE RECORD

Name Friendly's Ice Cream

Service No. 39

Address 66 Bedford St.

Location

~~Repair-Renewal~~ - New Service W.O. # 6801 *John Chiffard Jr #1478*

DEC 22 1969



Date		Material	Amount	Total	Date	Amount
9/29/69		Labor		13 60	9-3-69	300 00
		10% O.V.		1 36	12-22-69	153 26
	26'	1 1/2" Copper pipe	.1.50	12 00		146 74
		6 x 1 1/2" Service		19 43		
		1 1/2" Corporation cock		29 96		
		1 1/2" Curb cock		33 94		
		Road Box		15 15		
				146 74		
10-8-69	102'	1 1/2" Copper tubing				

DATE _____

TOWN OF LEXINGTON -- BOARD OF PUBLIC WORKS

WATER DIVISION

Sketch of Service Here

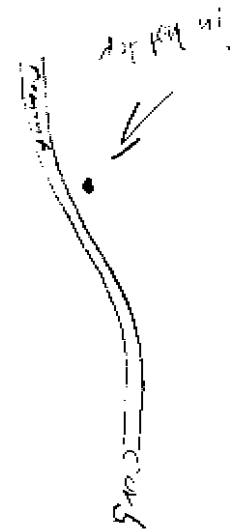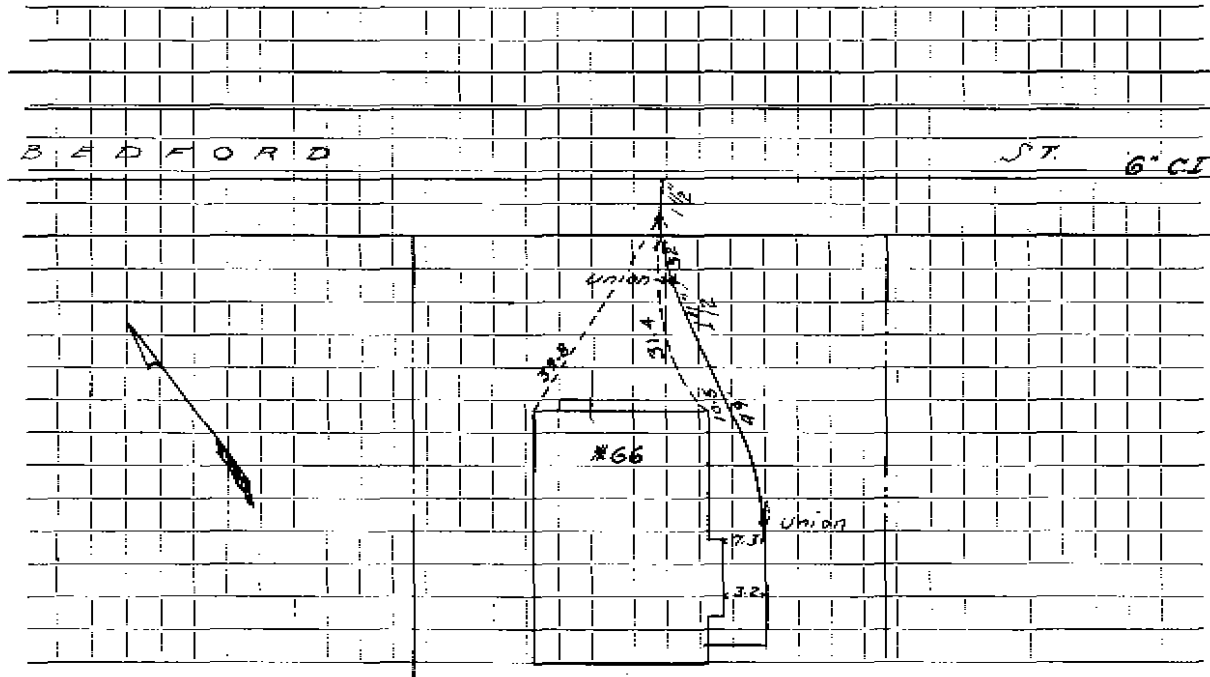

Connection made in Street. Work completed

Remarks:

.....

.....