

WATER SERVICE RECORD

Name Henry Balazy

Service No. 263

Address 69 & 71 Bedford Street

Location Renewal

~~Repair Renewal New Service~~

Am. 12-13-54


Date	Material	Amount	Total	Date	Amount
11/19/54	Labor	10 77		10-19-54 Deposited	40 00
	10% overhead	1 08	11 85	12-13-54 Refund	(1 20
	42' - 3/4" copper tubing@.35		14 70		<u>NON CHARGE</u> 38 80
	1 - 3/4"C x 1/2 I.W.H. stop & waste	4 00		11/19/54 Labor	33 00
	1 hr. Littlefield shovel	7 50		8' - 3/4" copper tubing@.35	2 80
	1 hr. trucking		75	1 - 3/4"C. corp-cock	4 33
			38 80	1 - 3/4"C. curb-cock	4 67
				1 box and rod	3 90
				1 - 1/2 straight tail pc.	50
				1 - 1/2 offset tail pc.	50
				1 hr. Littlefield shovel	7 50
				1 hr. trucking	75
				patching 4 x 3	4 00
					61 95

DATE _____

TOWN OF LEXINGTON — BOARD OF PUBLIC WORKS

WATER DIVISION

Sketch of Service Here

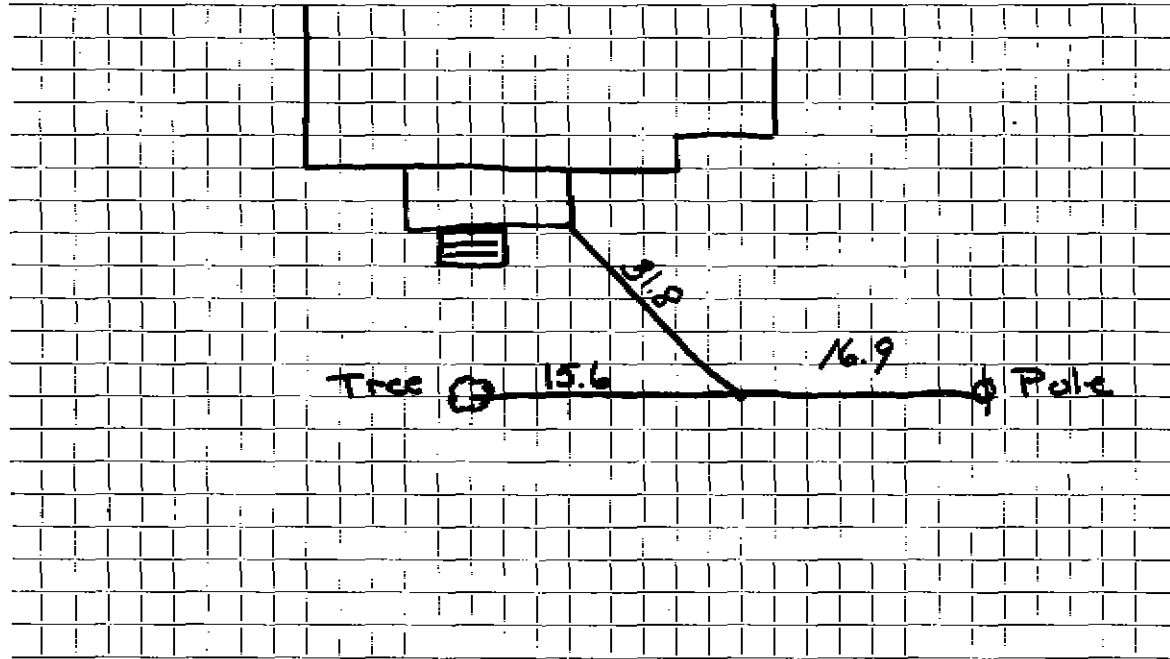

Connection made in Street. Work completed

Remarks:

.....

.....