

### WATER SERVICE RECORD

Name Margaret Curtis

Service No. 62

Address 7 Bedford Street

Location

~~REPAIR~~ Renewal - ~~REPAIR~~ W.O. #3193


OCT 3 1966

Date	Material	Amount	Total	Date		Amount
9/2/66	Labor	72 38		9-7-66	Deposit	75 00
	10% G.H.	7 24	79 62	11-14-66	Paid	36 26
16'	3/4" copper tubing @ .79		12 64			111 26
1	Yard Loam		3 00			
1	Hr. Truck		3 00			
2	Hrs. Tractor @ 6.50		13 00			
			<u>111 26</u>			
				8/23/58	OUTSIDE	
					Labor	54 80
	10' 3/4" Copper tubing @ .37					3 70
	1 3/4" C Corp Cock					4 64
	1 3/4" C Curb Cock					6 03
	1 3/4" Style 88 Repair Clamp					2 90
	3 Hrs. Pippin Backhoe @ 4.50					13 50
	2 Hrs. Trucking @ .75					1 50
						<u>87 07</u>
					Bill sent 3626	

DATE \_\_\_\_\_

**TOWN OF LEXINGTON — BOARD OF PUBLIC WORKS**  
**WATER DIVISION**

Sketch of Service Here

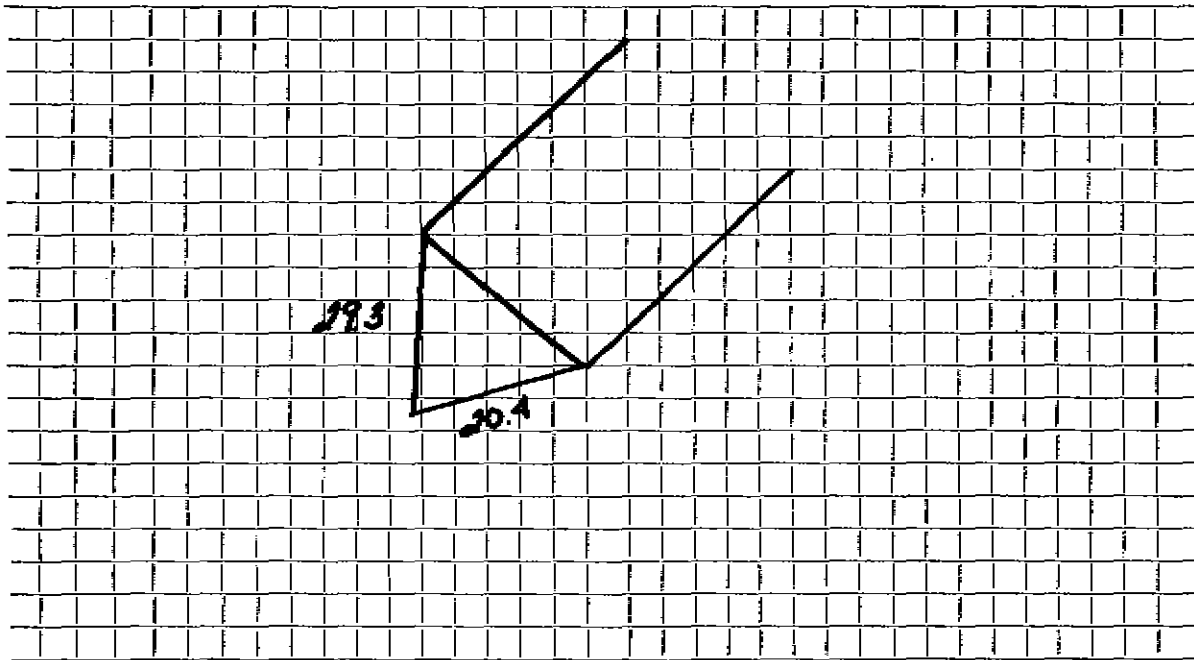

Connection made in ..... Street.      Work completed .....

Remarks: .....  
.....  
.....