

WATER SERVICE RECORD

Name *Custance Bros.*

Service No. 67

Address *#70 Bedford St.*

Location

Repair—Renewal—New Service *DeFlice Bros. #2442 W.O. #1561*

FEB 10 1975


Date		Material	Amount	Total	Date	Amount
<i>12-10-73</i>		<i>29'-1" Copper</i>			<i>11-29-73</i>	<i>Deposit 150.00</i>
<i>12/3</i>	<i>73</i>	<i>Labor</i>	<i>\$15.08</i>		<i>2-16-75</i>	<i>Ret 57.18</i>
<i>n</i>		<i>10% O.H.</i>	<i>1.51</i>	<i>\$16. 59</i>		<i>92.82</i>
	<i>25'</i>	<i>1" Copper tubing @ 1.35</i>		<i>33. 75</i>		
	<i>1</i>	<i>1" Curb Cock</i>		<i>16. 97</i>		
	<i>1</i>	<i>1" Corp Cock</i>		<i>15. 17</i>		
	<i>1</i>	<i>Box and Rod</i>		<i>7.34</i>		
	<i>1</i>	<i>hr Trucking</i>		<i>3. 00</i>		
		<i>Total</i>		<i>\$92. 82</i>		

NOT IN USE

DATE _____

TOWN OF LEXINGTON — BOARD OF PUBLIC WORKS
WATER DIVISION

Sketch of Service Here

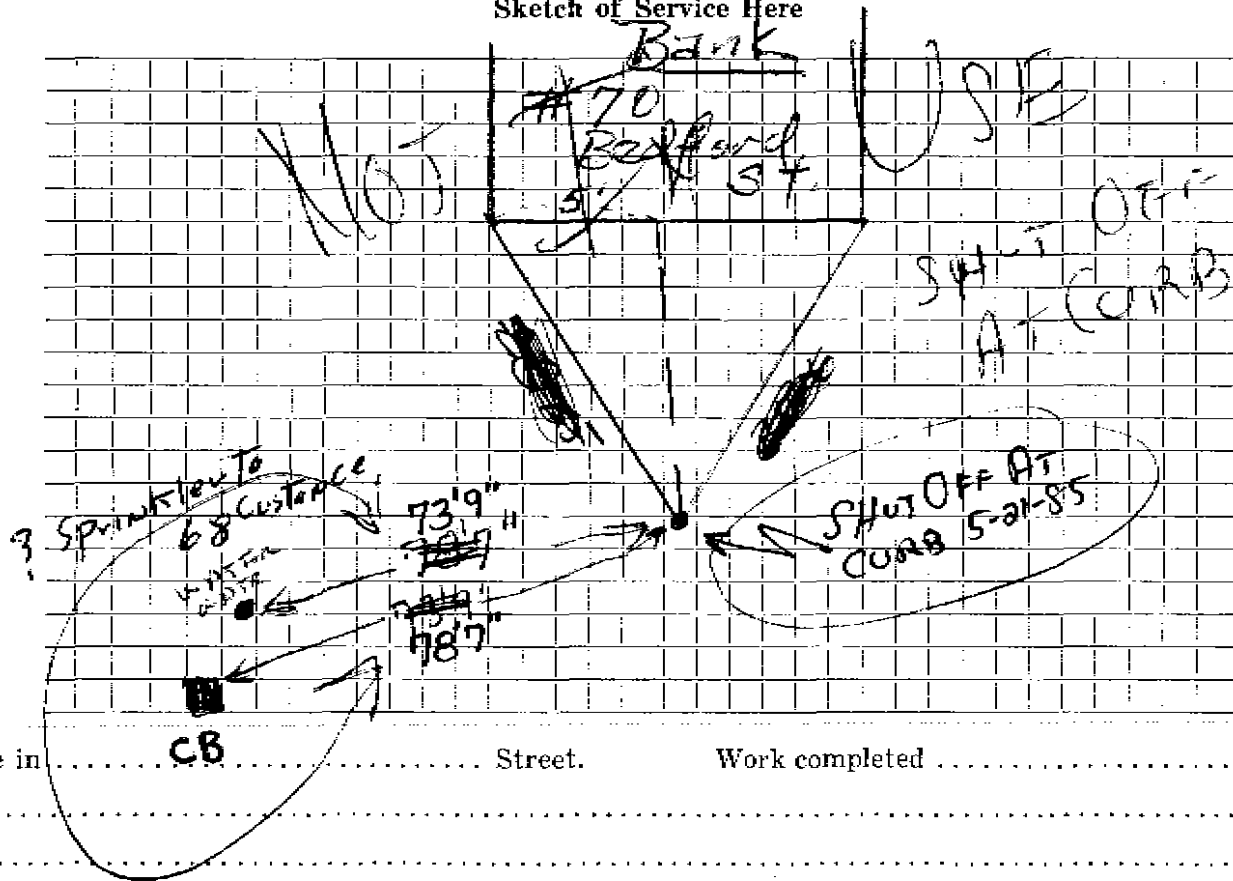

Connection made in Street. Work completed

Remarks: