

WATER SERVICE RECORD

Name James P. Curran

Service No. 185

Address 73 Bedford Street

#7743

Location Lexington

~~x Repair~~ - Renewal - ~~New Service~~

Comm. 10-28-57

Date	Material	Amount	Total	Date	Amount
8-26-57	labor	58 30		8-20-57	Deposit \$100 00
8-27-57		28 76		6-16-58	Paid 16 48
	10% overhead	8 71	95 77		\$116 48
	40' 3/4" copper tubing @ .375		15 00		NON CHARGE
	1 3/4" C x 1/2 IWH stop & waste		4 96		labor 48 55
	1 hr trucking @ .75		75		12' 3/4" copper tubing .375 4 50
			116 48		1 3/4" c curb cock 5 94
					1 3/4" c corp cock 4 64
					1 box & rod 4 62
					1 straight tail piece 50
					1 1/2 offset tail piece 50
					1 hr town shovel @6.50 6 50
					2 hrs trucking @.75 1 50
					12 x 3 patch 12 00
					<u>89 25</u>


Bill sent 10-30-57
\$16.48

DATE _____

TOWN OF LEXINGTON — BOARD OF PUBLIC WORKS

WATER DIVISION

Sketch of Service Here

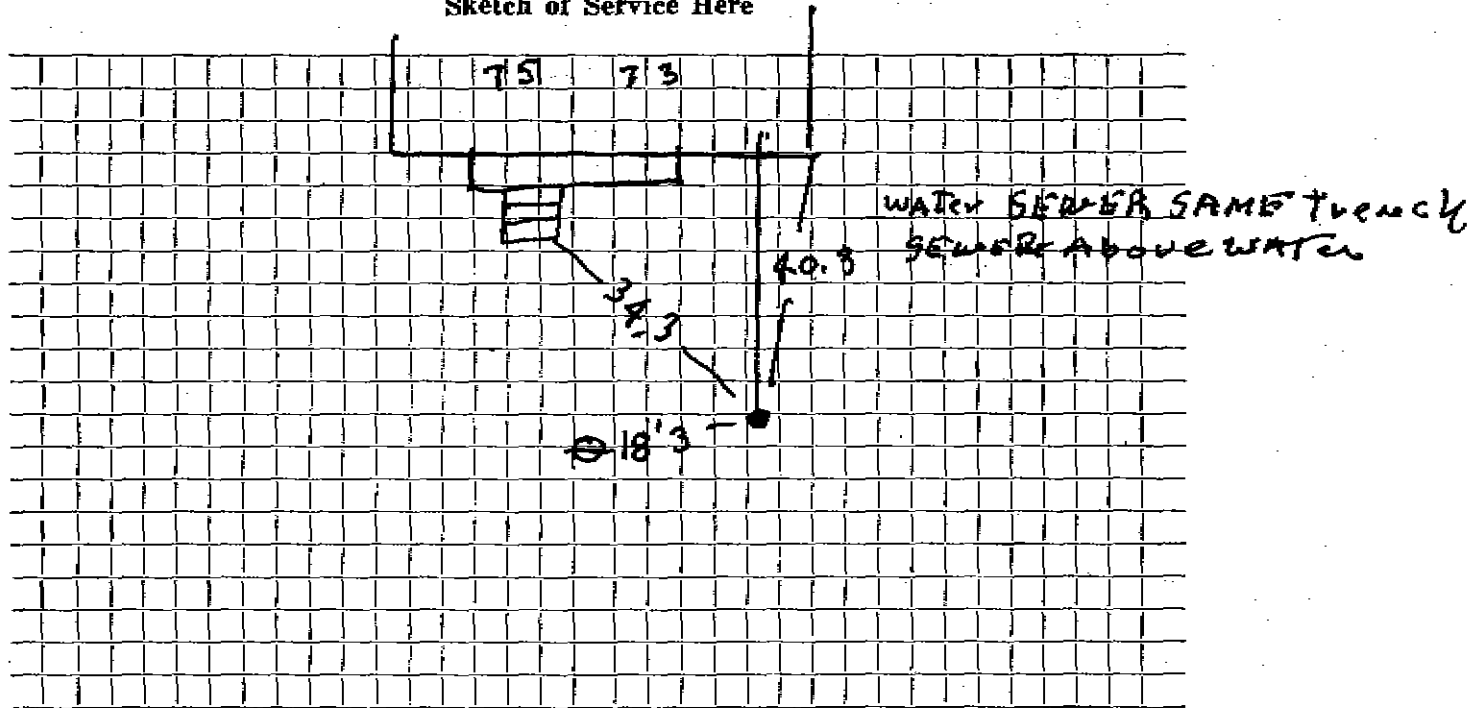

Connection made in BEDFORD ST. Street. Work completed

Remarks:
.....
.....