


DATE _____

TOWN OF LEXINGTON — BOARD OF PUBLIC WORKS

WATER DIVISION

Sketch of Service Here

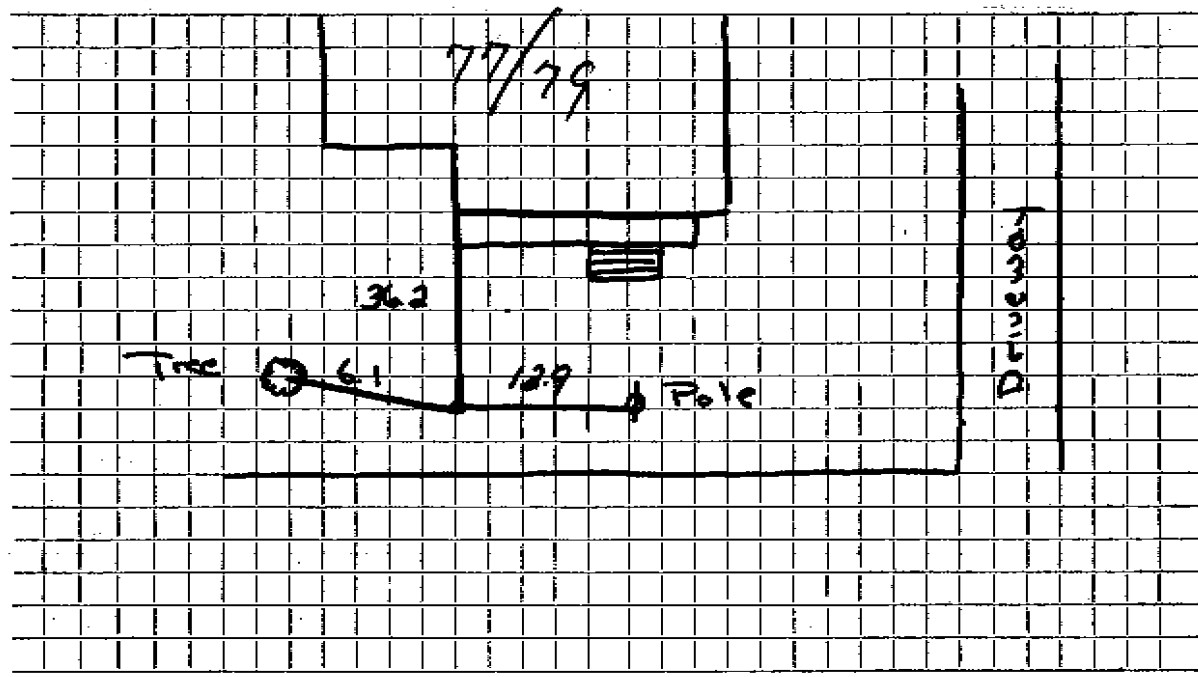

Connection made in Street. Work completed

Remarks:
.....
.....

Name Audley Brown

Service No.

Address 77-79 Bedford Street
Lexington, Mass.

Location 77-79 Bedford Street

Kind of Pipe

Size

Size of Main

~~Repair~~—~~Renewal~~—~~New Service~~

Location

Date	Material	Amount	Total	Date	Amount
Sept. 25, '48	Labor	21 87	21 87	Sept 23 '48	40 00
	100 Overhead		2 19	Oct 20 '48	
	10' - 3/4" Copper Tubing	8.255	10 20		Non-Charge
	1 - 3/4" G x 3/4" W.P. S & W		3 15	Sept. 25, '48	Labor
	Trucking 1 hr.	0.75	75		31 53
			38 16		9' - 3/4" Copper tubing
					8.255
					2 30
					1 - 3/4" G carb-cock
					3 00
					1 - 3/4" G x 3/4" G carb-cock
					3 68
					1 - sock & rod
					3 55
					1 - 1/2" Offset Tail Piece
					30
					Comp. 3 hrs. @ 1.75
					5 25
					Trucking 1 hr. @ .75
					75
					Patching 6 x 3
					6 00
					56 46

Com. 10/25/48

Labor

DATE _____

TOWN OF LEXINGTON—BOARD OF PUBLIC WORKS

WATER DIVISION

The undersigned applies for a supply of water at No. _____ St. and hereby agrees to comply with the rules and regulations as now, or at any future time, established by the Board of Selectmen.

Am't. of Estimate \$ _____

Owner _____


Am't. Paid \$ _____

Address _____

77/79

Builder _____

Sketch of Service Here

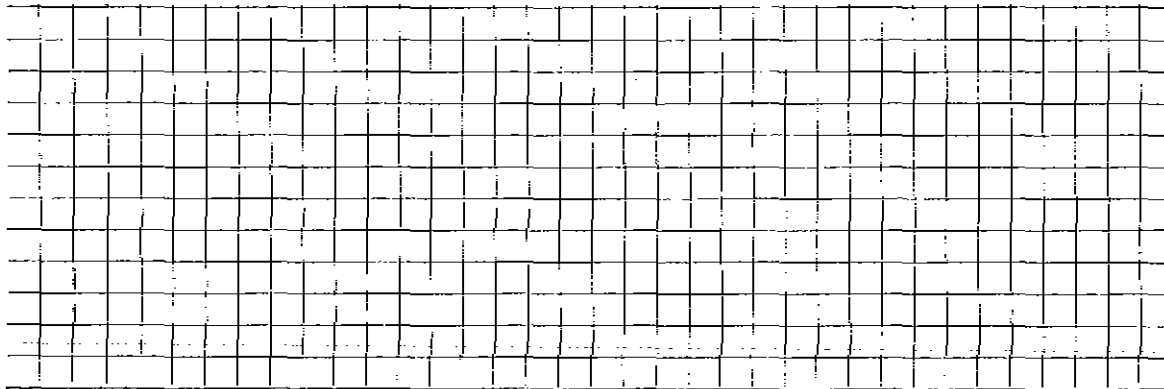

Connection made in _____ Street. Work completed _____ 19

Remarks: