





WATER SERVICE RECORD

Name Minnie S. Britton

Service No. 43 #4530

Address 8 Bedford Street

Location Lexington, Mass.

~~Repair-Renewal-New Service~~


Com. 5-21-51

Date	Material	Amount	Total	Date	Material	Amount
4-7-51	Labor	13 13	13 13	<i>Munroe's</i>	<i>Repaired</i>	40 00
	10% Overhead		1 31			
	53' - 3/4" Copper Tubing @ .36		19 08		No Charge	
	1 - 3/4" C x 1/2" I.W.H. S&W		4 00	4-7-51	Labor	38 00
	1 - 3/4" C x 3/4" C Union (3pts)		1 72	1 - 1/2" Offset Tail Piece		50
	Trucking 1 hr. @ .75		75		Renewed	38 50
			39 99	8/13/87	14' 3/4" Copper	
					3/4" Curb	
					3/4" Corp	
					1 Curb Box	
					9 yds Gravel	
					1 1/2 ton Cold Patch	

DATE \_\_\_\_\_

TOWN OF LEXINGTON — BOARD OF PUBLIC WORKS  
WATER DIVISION

Sketch of Service Here

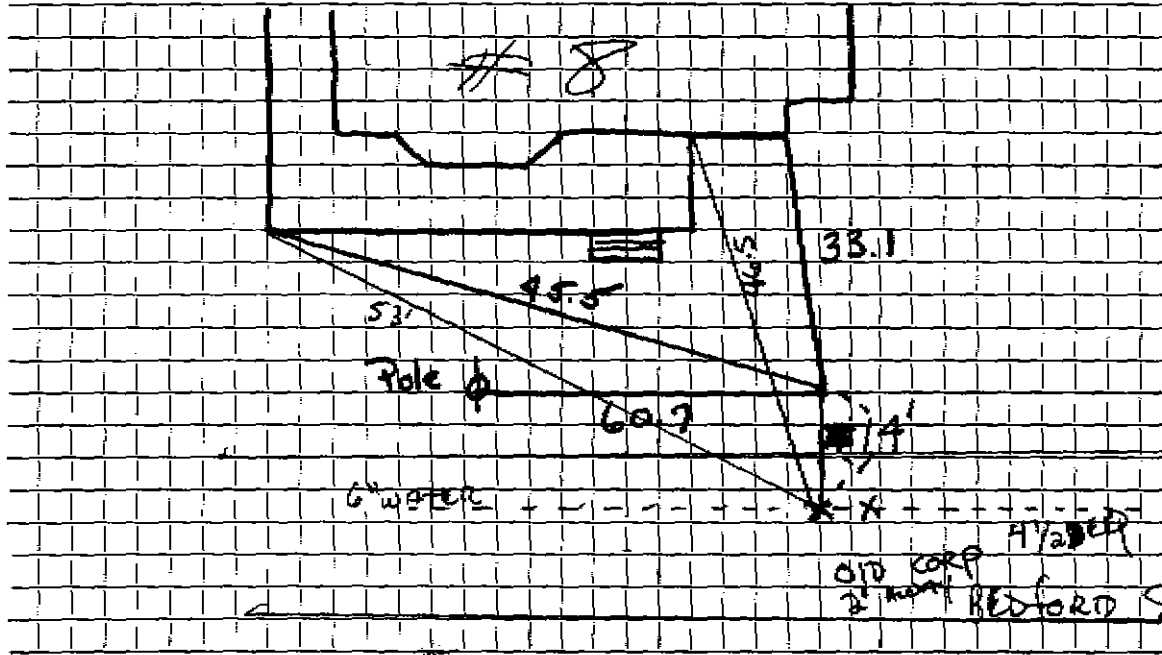

Connection made in ..... Street. .... Work completed .....

Remarks: .....

.....

.....