

WATER SERVICE RECORD

Name

Service No.

Address 80 BEDFORD ST

Location


Repair - ~~Renewal~~ - New Service McLaughlin

Date	Material	Amount	Total	Date	Material	Amount
9/13/27	1 1/4 CLP					
2/1/00	82' 1" COPPER			10/7/59	10' 1" COPPER	
	2 1/4 FX 1" COMP				1 1" CURB COCK	
	1 1/4 X 1/2" BRASS NIPPLE				1 1" ADAPTER-CORP	
	1 1/4-100 DRESSER COMP				10' X 3' PATCH	
	1 BUFFLO BOX					

DATE _____

TOWN OF LEXINGTON — BOARD OF PUBLIC WORKS
WATER DIVISION

Sketch of Service Here

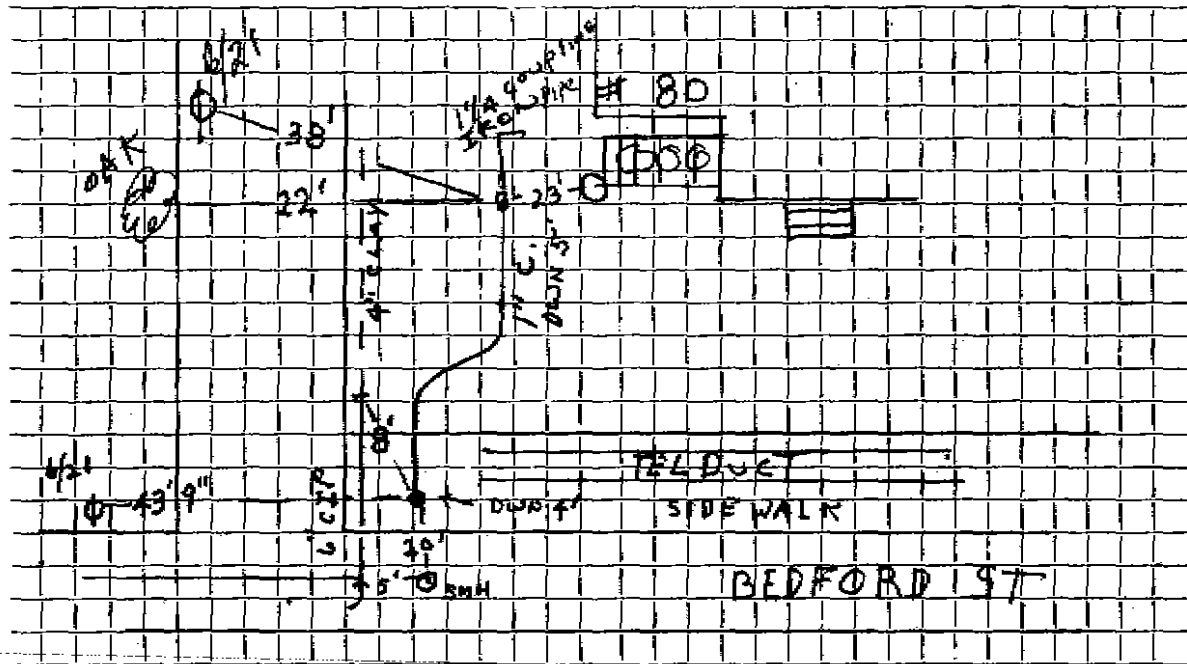

Connection made in Street. Work completed

Remarks: SEWERS 1' TO LEFT OF WATER. DWN 4' IN SIDEWALK. SEWER IS 6\"/>.....
.....