

WATER SERVICE RECORD

Name William Rice

Service No. 15

Address 81 Bedford Street

#6863

Location

~~REPAIR~~ - Renewal - ~~NEW SERVICE~~

W.O.#6630

NOV 18 1968


Date	Material	Amount	Total	Date	Amount
5-6-68	Labor	45.90		5-6-68	280 10
6-21-68	"	15.27	61.12	11-18-68	151 18
	10% O.H.	6.12	67.29		128 82
37'	3/4" Copper tubing @.79		29.23		OUTSIDE
1	3/4" Wheel Valve		9.30	5-6-68	Labor 76.50
2	yds Loam		7.00	6-11-68	" 16.02
1	hr. Trucking		3.00	6-12-68	" 11.58
2	hrs. Town Shovel		13.00	7'	3/4" Copper tubing 5.53
			128.82	1	3/4" Curb Cock 11.32
				1	3/4" Deep Cock 9.57
				1	Box & Rod 5.10
				1/4	ton Cold Patch 1.39
				2 1/2	ton Hot Top @5.80 14.50
				2	hrs. Town Shovel @6.50 13.00
				2 1/2	hrs. Trucking @3.00 7.50
				1/2	hr. Compressor @5.00 2.50
				1/2	hr. Roller 1.50
					176.01

DATE _____

TOWN OF LEXINGTON — BOARD OF PUBLIC WORKS

WATER DIVISION

Sketch of Service Here

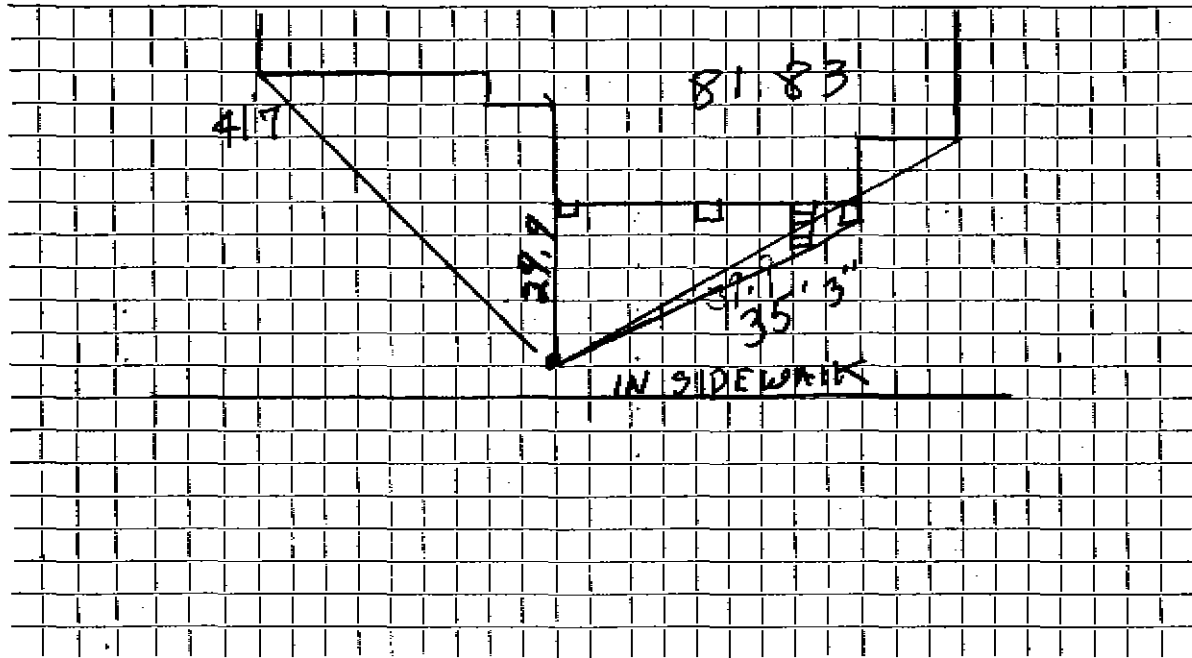

Connection made in Street. Work completed

Remarks:

.....

.....