

Name Edward A. Plugis

Service No. 4-135

Address Woburn, R.F.D.  
89 & 91 Bedford St.

#7725

Location

89 Bedford St.,

Kind of Pipe

Size

Size of Main

~~Repair~~ ~~Renewal~~ ~~New Service~~

Location

Date	Material Chargeable	Amount	Total
2/25/42	1 hr.	60	
Jan 7/6/42	1 "	70	1 30
	10% Overhead		13
	132' 3/4" Copper tubing @ 21¢	27 72	
	2 3/4" C.Unions (3 parts) @ 1.	2 00	
	1 3/4" x 3/4" I.W.H.S. & W.	2 50	
	1 hr. trucking		75
			<u>34 40</u>
	Curb to Main (Not Chargeable)		
	10' 1" Copper tubing @ 21¢	2 10	
	1 1" C. Corp. cock	2 25	
	1 1" C.xl 1" I. Curb cock	3 96	
	1 1" I x 3/4" C Union	88	
	1 3/4" Str. Tail piece	38	
	1 3/4" Labor Offset tail piece	38	
	1 Box & Rod	1 65	
	1 hr. trucking	75	
		12 35	
	Labor	1 30	
		<u>13 65</u>	

Date	Amount
February 5 1942	50.00
Deposited	20.60
Refund	<u>34.40</u>

Hadley Press, Inc., Lexington

DATE \_\_\_\_\_

# TOWN OF LEXINGTON—BOARD OF PUBLIC WORKS

## WATER DIVISION

The undersigned applies for a supply of water at No. 89 Bedford St. and hereby agrees to comply with the rules and regulations as now, or at any future time, established by the Board of Selectmen.

Am't. of Estimate \$ \_\_\_\_\_


Owner Edward A. Plugis

Am't. Paid \$ \_\_\_\_\_

Address Watson T.H.D.

Builder \_\_\_\_\_

Sketch of Service Here

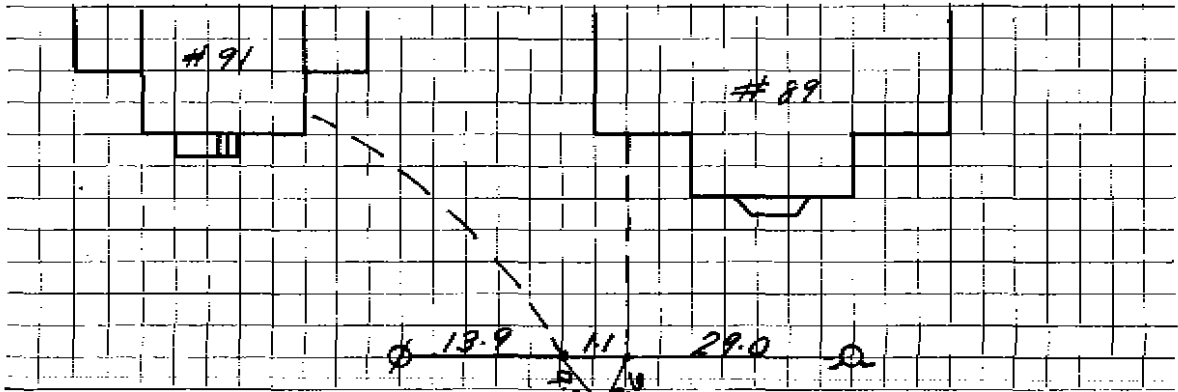

Connection made in \_\_\_\_\_

Remarks:

Street  
S.M.H.

Work completed \_\_\_\_\_ 19