




DATE 8/8/2014

TOWN OF LEXINGTON — BOARD OF PUBLIC WORKS

WATER DIVISION

Sketch of Service Here

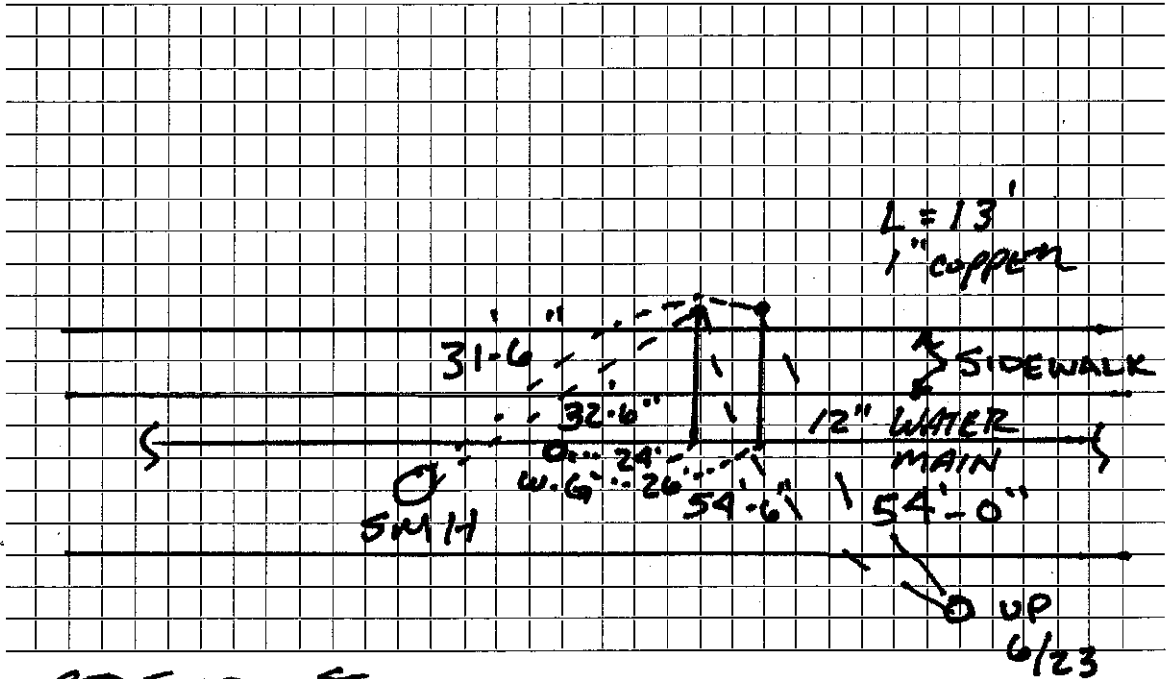

Connection made in... BEDFOLD ST. Street. Work completed .....

Remarks:.....  
TWO NEW 1" WATER SERVICES FOR 95/97  
BEDFORD ST.