

WATER SERVICE RECORD

Name Cemetery Department - Town of Lexington

Service No. 233 ND

Address Westview Cemetery

Location

~~Repair~~ ~~Renew~~ New Service


Comm. 10-24-60

Date	Material	Amount	Total	Date	Amount
9-19-60	Labor	119.02		1960	Paid
	10% O.H.	11.50	130.92		
	334' 1" Copper tubing @4.676		156.18		
	5 1" Unions 3 part @3.98		19.90		NOT CHARGE
	1 1" x 1" Comp. Valve		6.06	9-19-60	Labor
	1 1" x 3/4" Bushing		.94		5' 1" Copper tubing @.4676
	4 x 3 Patch		4.00		1 1" C Corp Cock
	8 hrs. Pippin Shovel @4.50		36.00		1 1" C Curb Cock
	5 hrs. Trucking @.75		3.75		1 Box & Rod
	1 hr. Dozer @3.00		3.00		1 hr. Pippin Shovel @4.50
			361.65		1 hr. Trucking @.75
					1 3/4" Straight tailpiece
					1 3/4" Offset tailpiece
					33.27

DATE _____

TOWN OF LEXINGTON — BOARD OF PUBLIC WORKS

WATER DIVISION

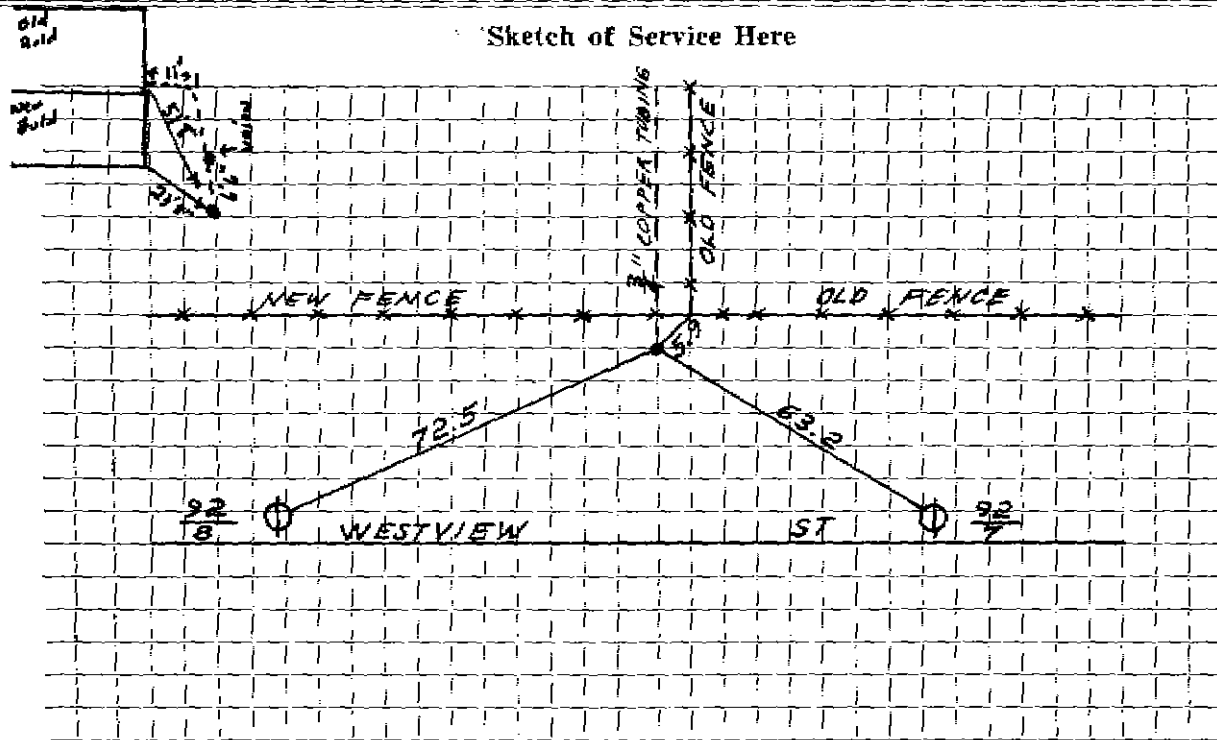

Connection made in Street. Work completed

Remarks:
.....
.....