




DATE \_\_\_\_\_

TOWN OF LEXINGTON — BOARD OF PUBLIC WORKS

WATER DIVISION

MASONIC HALL

Sketch of Service Here

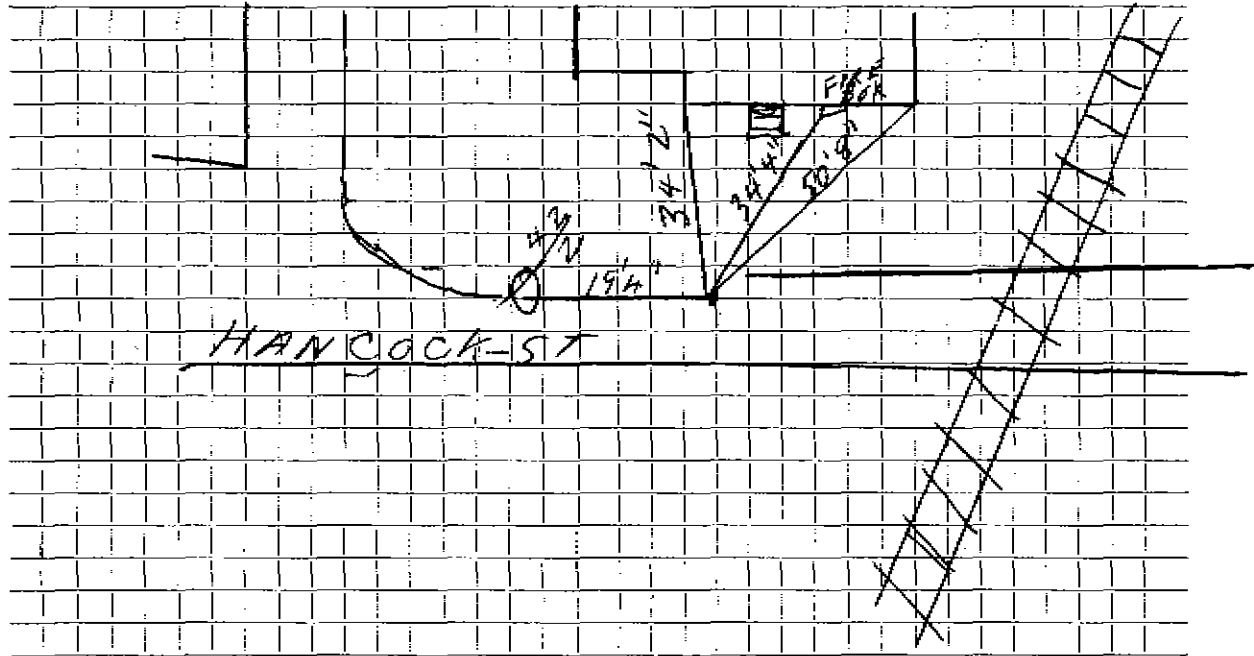

Connection made in ~~FRONT~~ - OUTSIDE Street.

Work completed .....

Remarks: ~~FRONT~~ - IN SIDE  
COPPER