


Date: 6/8/2023

TOWN OF LEXINGTON - BOARD OF PUBLIC WORKS
~~WATER~~ ~~SEWER~~ DIVISION

SKETCH OF SERVICE HERE

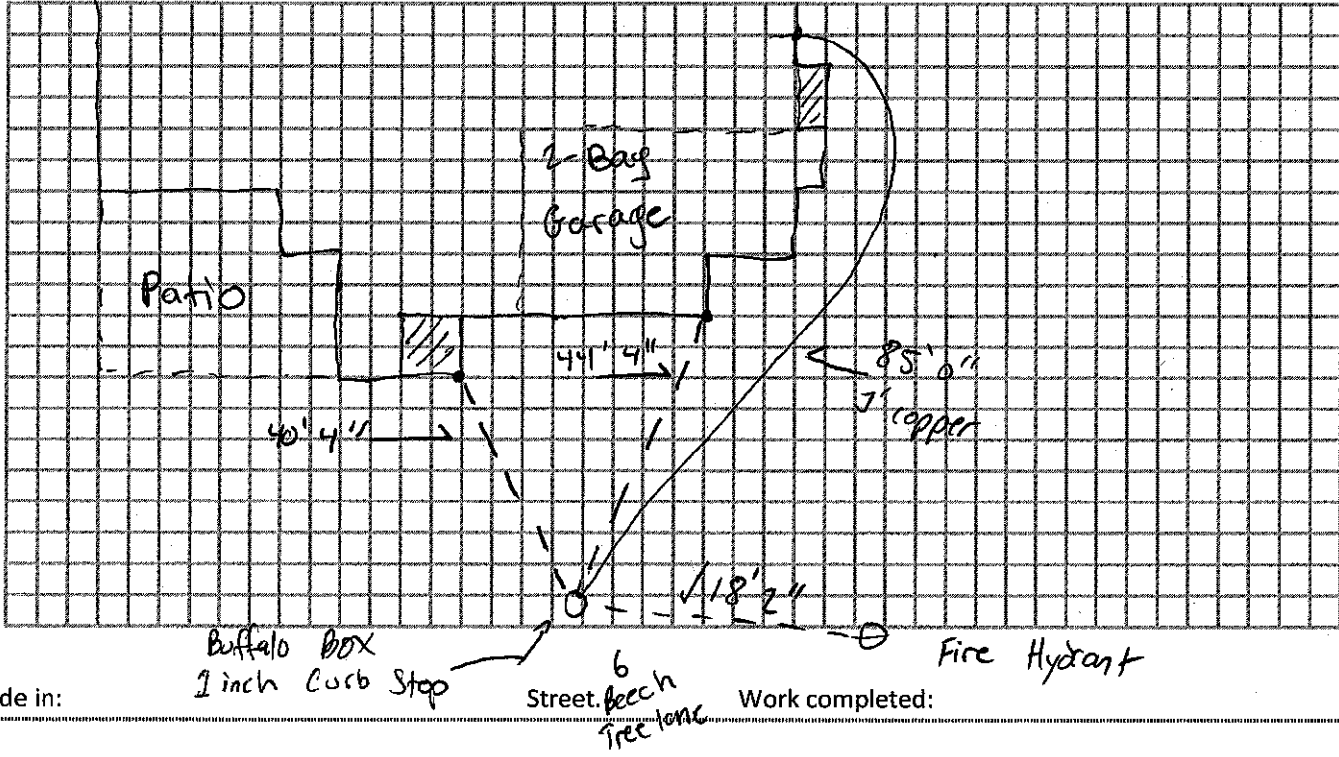

Connection made in:

Remarks:

INSTALLED By McLAUGHLIN