

WATER SERVICE RECORD

Name ~~Miss~~ Edith Litchfield

Service No. 224

Address 1 - 3 Belfry Terrace

Location Lexington, Mass.

Repair ~~Renewal~~ ~~New Service~~


AM 12-1-51

Date	Material	Amount	Total	Date	Material	Amount
10/31/51	Labor	22 92	22 92	9-14-51	<i>Deposited</i>	50 00
	10% overhead		2 29	12-3-51	<i>Withdrawal</i>	(8 96
	34' - 3/4" copper tubing @ .326	11 08			<u>NO CHARGE</u>	11 04
	1 - 3/4" C x 1/2" I.F.H. stop & waste	4 00		10/31/51	Labor	22 92
	1 hr. trucking		75	27' - 3/4" copper tubing @ .326		8 80
			41 04	1 - 3/4" C. adapter		1 82
				1 - 3/4" C x 3/4" C. curb-cock		4 67
				1 - 3/4" C x 3/4" C. union (3pt.)		1 72
				1 - box and rod		4 68
				1 - 1/2" straight tail piece		50
				1 - 1/2" offset tail piece		50
				1 hr. trucking		75
				patching 15 x 3		15 00
						51 36

DATE _____

TOWN OF LEXINGTON — BOARD OF PUBLIC WORKS
WATER DIVISION

Sketch of Service Here

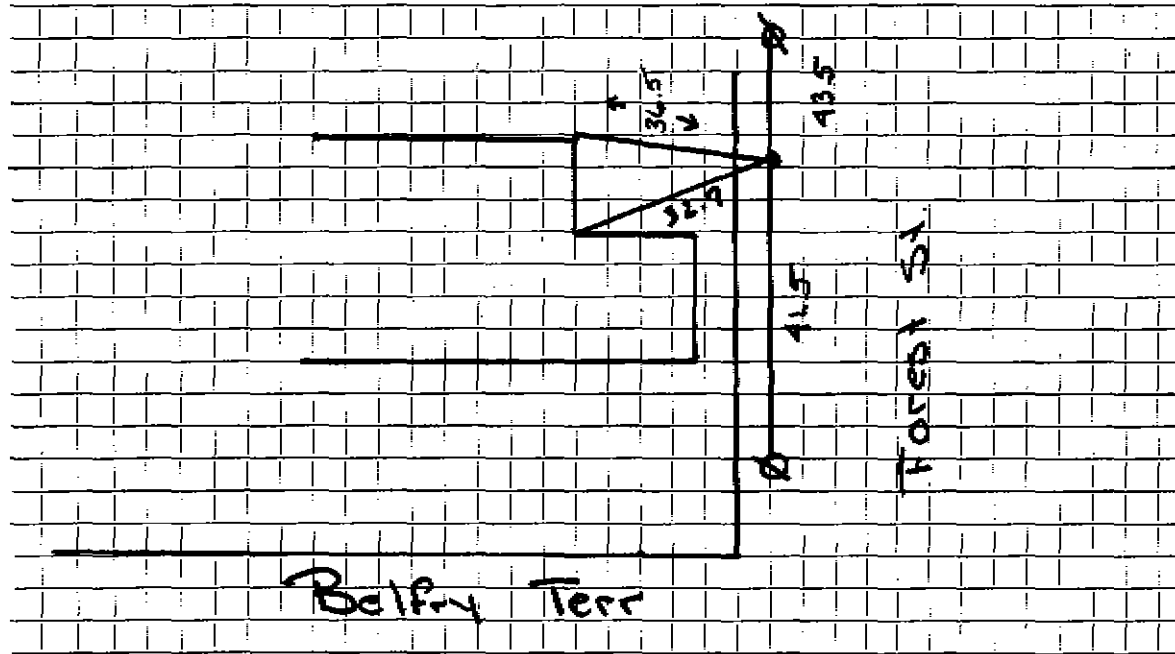

Connection made in Street. Work completed

Remarks:

.....

.....