

WATER SERVICE RECORD

Name

Service No.

Address 10 BELFREY TER.

Location


Repair—Renewal—New Service RENEWAL

| Date | Material | Amount | Total | Date | Amount |
|-----------------|-------------------------------------|--------|-------|-------------|---------------------------|
| 11/9 4/08/32 | 93 26' OF 3/4" COPPER 31' C.L.P. | | | | |
| | | | | | OUTSIDE RENEWAL BY TOWN |
| | | | | 7/30/75 14' | 3/4" Copper Pipe |
| | | | | 1 | 3/4" Curb Stop |
| | | | | 1 | 3/4" Corp. Adapter |
| | | | | 1 | 1" Style 38 Dresser Cplg. |

DATE 11/9/93

TOWN OF LEXINGTON — BOARD OF PUBLIC WORKS
WATER DIVISION

Sketch of Service Here

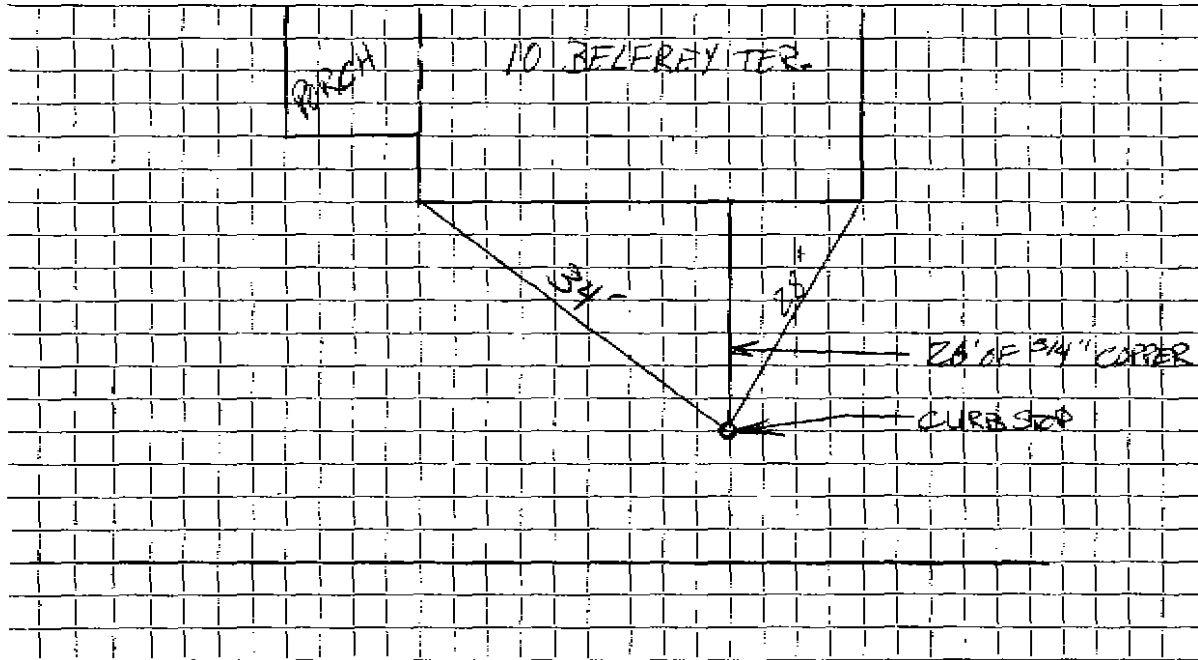

Connection made in Street. Work completed

Remarks:

.....

.....