

WATER SERVICE RECORD

Name

Service No.

Address 11 Belfrey Terrace

Location

~~Repair~~—~~Renewal~~—~~New Service~~


Date	Material	Amount	Total	Date	Amount
6/14/28					
	1" C.L.P.				
8/2/95	Renewed 3/4" COPPER				
8-8-95	Repaired 1-1/2" 3part union 1-1" Corp.			8-1-75	
					Outside Renewal(Non-charge) W.O.#B563.
					Labor 150.56
					10 % O.H. 15.06
					\$165.62
				28'	3/4" Copper Pipe @1.05 29.40
				1	3/4" Curb Stop 13.70
				1	1" x 6" Nipple .90
				1	1" Style 38 Dresser Cplg. 5.25
				1	3/4" Lead to copper Fitting 1.75
				1	Hr. Trucking 3.00
				1	Hr. Pickup 1.50
				3	Hrs. Backhoe @6.50 19.50
					\$240.62

DATE _____

TOWN OF LEXINGTON — BOARD OF PUBLIC WORKS

WATER DIVISION

Sketch of Service Here

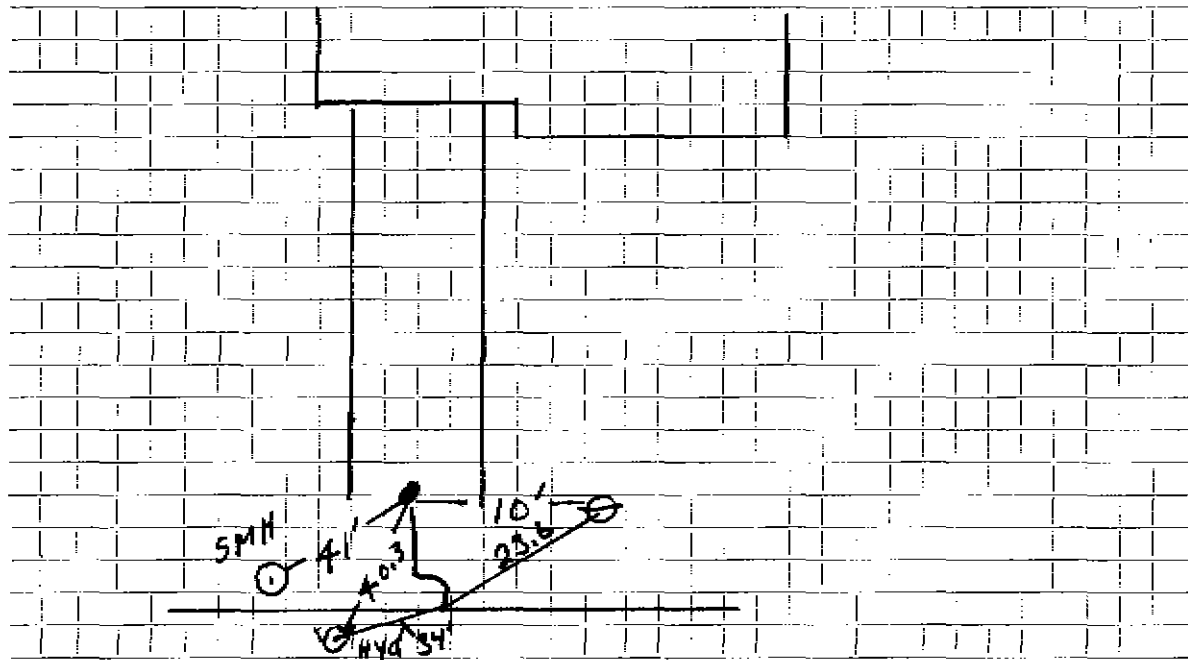

Connection made in Street. Work completed

Remarks: *6 1/2 deep @ main*

.....
.....