

WATER SERVICE RECORD

#4905
56 #17

Name Paul Whipple

Service No.

Address 15 Balfry Terrace

Location Lexington

~~Repair~~ - ~~Renewal~~ - ~~New Service~~

Com. 6-16-52


Date	Material	Amount	Total	Date	Amount
5/1/52	Labor	22 85		4-18-52	Deposited 45 00
	10% overhead	2 29	25 14	6-16-52	Refunded (2 73)
	36' - 3/4" copper tubing @ .3439	12 38			NON CHARGE 42 27
	1 - 3/4" C x 3/4" I.W.F. stop & waste	4 00		5/1/52	Labor 36 00
	1 hr. trucking		75		20' - 3/4" copper tubing @ .3439 6 37
			42 27		1 - 3/4" C. adapter 1 95
					1 - 3/4" C x 3/4" C. curb-cock 4 67
					1 - 3/4" C x 3/4" C. union 1 72
					1 - box and rod 4 52
					1 - 1/2 offset tail piece 50
					1 - 1/2 straight tail piece 50
					1 hr. trucking 75
					57 48

DATE _____

TOWN OF LEXINGTON — BOARD OF PUBLIC WORKS

WATER DIVISION

Sketch of Service Here

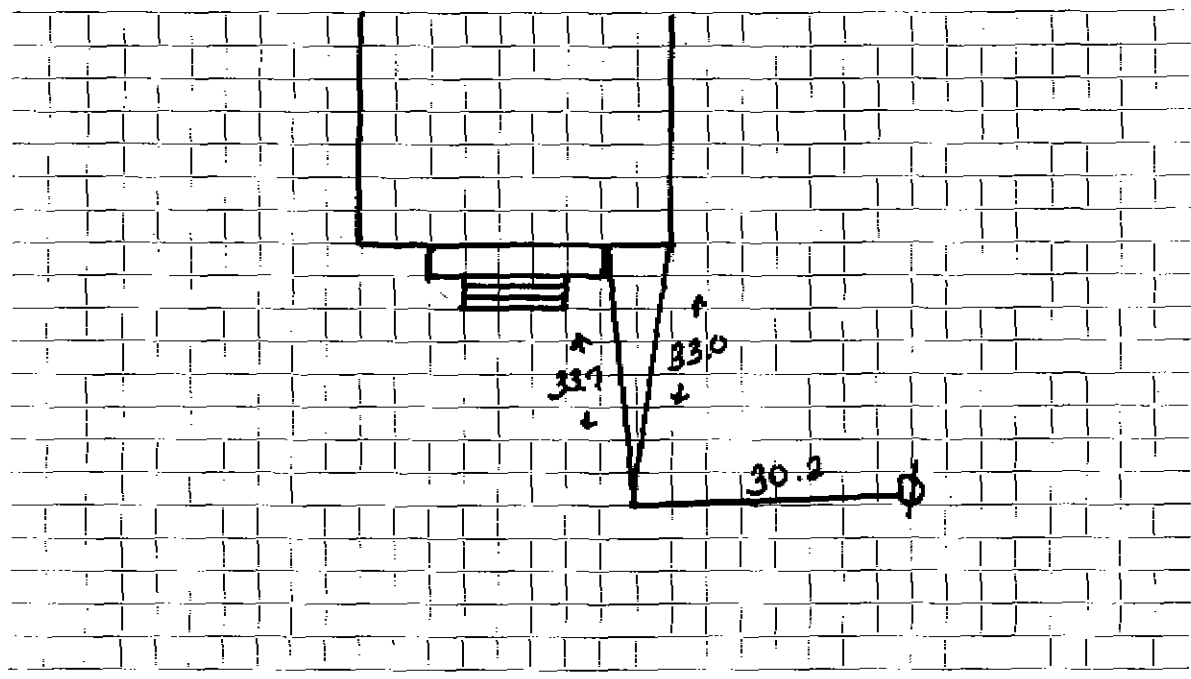

Connection made in Street. Work completed

Remarks:
.....
.....