

Name M. Bowman Judkins

Service No. ~~10~~ 234

Address Grassland Street, Lexington

3968

Location 16 Belfry Terrace Circle

Kind of Pipe

Size

Size of Main

~~Repair - Rework~~ - New Service

Location

Date

Material

Amount

Total

Date

Amount

1930

June 3

3 Hrs. Labor @ 60¢

1 80

*Com. to Russell
L.S.P. 35 #1173*

10% Overhead

18

1 98

60' 3/4" Copper Pipe ^{220¢}

12 00

1 S. & W.

2 75

Trucking

1 00

15 75

17 73

1931

May 14

June 26

Deposited

15 75

1 98

17 73

Labor

351
45
17
5
11
17

DATE May 14, 1935

TOWN OF LEXINGTON—BOARD OF PUBLIC WORKS

WATER DIVISION

The undersigned applies for a supply of water at No. 16 Belfry Terrace Circle St. and hereby agrees to comply with the rules and regulations as now, or at any future time, established by the Board of Selectmen.

Am't. of Estimate \$ 15.75

Owner Chester S. Cook


Am't. Paid \$ _____

Address Forest St.

Builder M. B. Jenkins

Lexington

Sketch of Service Here

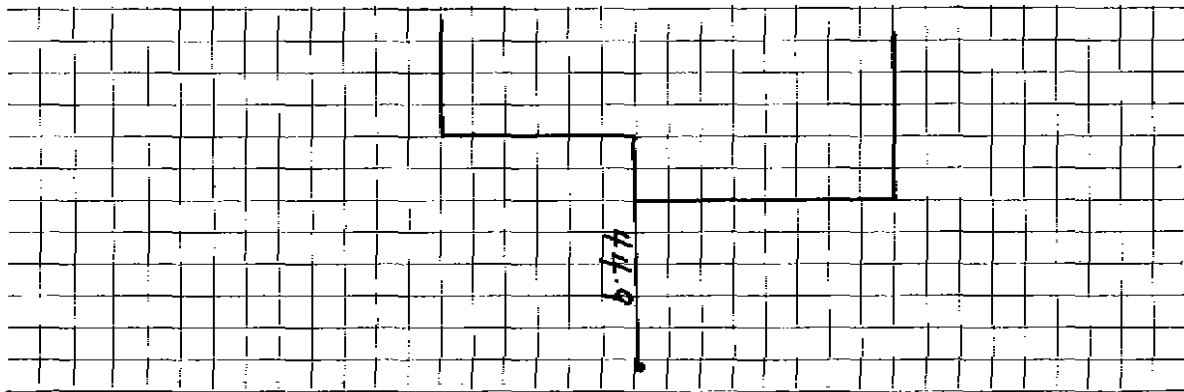

Connection made in _____ Street. Work completed _____ 19

Remarks: