




DATE \_\_\_\_\_

TOWN OF LEXINGTON — BOARD OF PUBLIC WORKS

WATER DIVISION

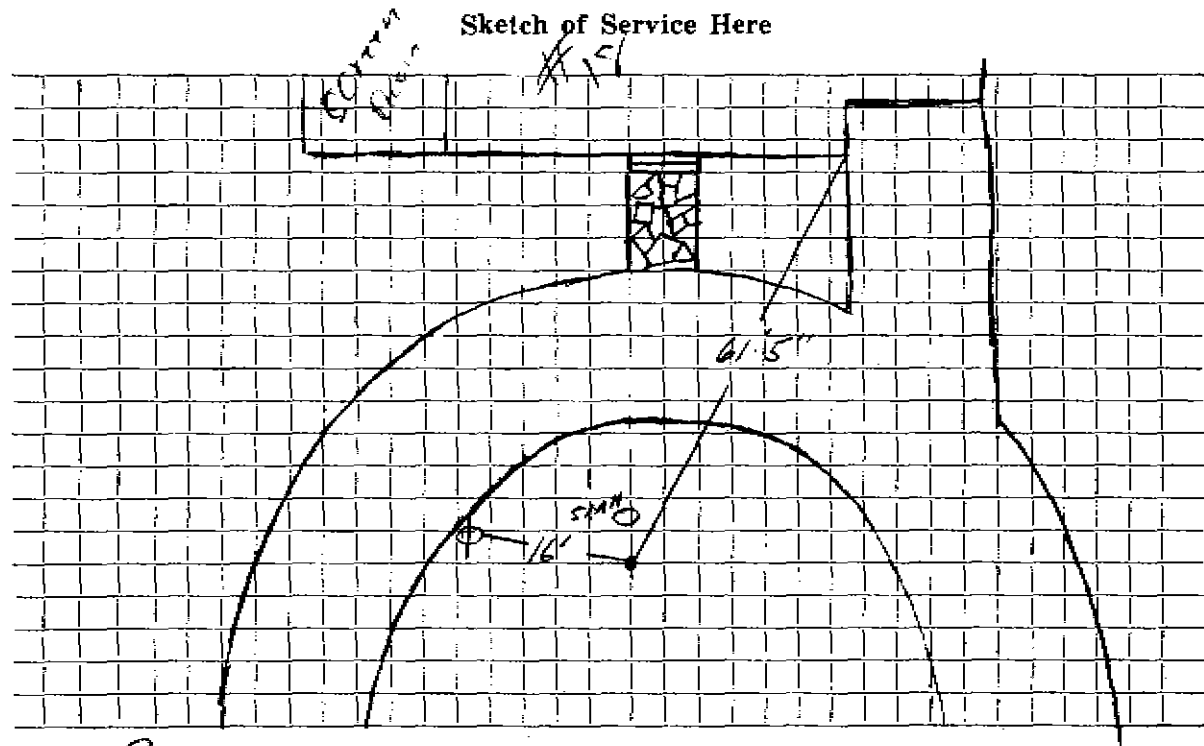

Connection made in Becky Terr Street. Work completed \_\_\_\_\_

Remarks: curb in island gate type curb with a red curb  
.....  
.....