

WATER SERVICE RECORD

Name

Service No.

Address 5 & 7 Belfry Terrace

3577, 3578

Location


-Repair—Renewal—New Service

Date	Material	Amount	Total	Date	Amount
11/06/34	32' 3/4" C. Pipe				
	1 S & Waste				
					NON CHARGE
				6/25/63	Labor 61 20
				26'	3/4" Copper tubing @.42 10 92
				1	3/4" C. Adapter 1 62
				1	3/4" C. Curb Cock 6 28
				1	Box & Rod 4 90
				3	hrs. Town Shovel @ 6.50 19 50
				2	hrs. Trucking @ 3.00 6 00
					110 42

TOWN OF LEXINGTON — BOARD OF PUBLIC WORKS

WATER DIVISION

Sketch of Service Here

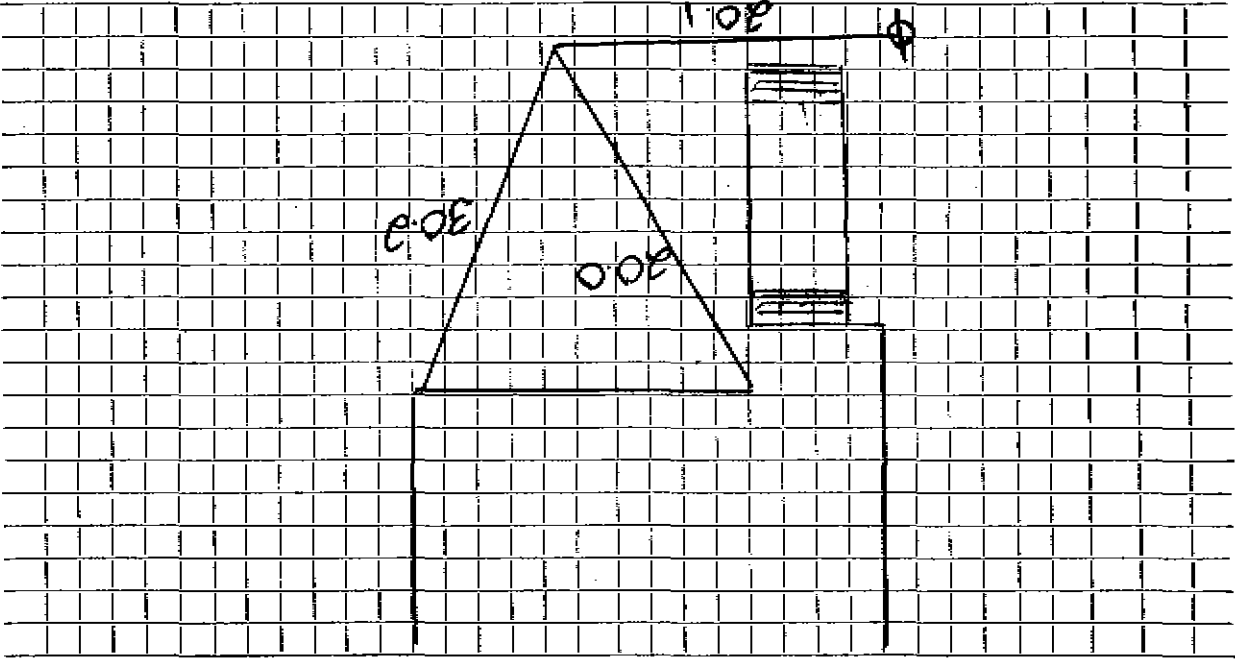

Connection made in Street. Work completed
Remarks: