

Name

John Deutch

Service No. 229

Address

6 Belfry Terrace

#4010

Location

6 Belfry Terrace

Kind of Pipe

Size

Size of Main

Repair—Renewal—New Service

Location

Date

Material

Amount

Total

Date

Amount

 Outside Renewal(Non-charge) ^{W.O.} #3563

7-31-75

Labor

\$94.10

10% O.H.

9.41

\$103.51

14' 3/4" Copper Pipe @1.05

14.70

1 3/4" Adapter

5.12

1 3/4" Curb Stop

13.70

1 Box & Rod

15.40

1 1" Style 38 Dresser Cplg.

5.25

1 6" x 1" Nipple

.90

1 Hr. Trucking

3.00

1 Hr. Pickup

1.50

3 Hrs. Backhoe @6.50

19.50

\$182.58

Labor

DATE _____

TOWN OF LEXINGTON—BOARD OF PUBLIC WORKS

WATER DIVISION

The undersigned applies for a supply of water at No. _____ St. and hereby agrees to comply with the rules and regulations as now, or at any future time, established by the Board of Selectmen.

Am't. of Estimate \$ _____

Owner

William Ferguson


Am't. Paid \$ _____

Address

6 Belfry Terrace

Builder _____

Sketch of Service Here

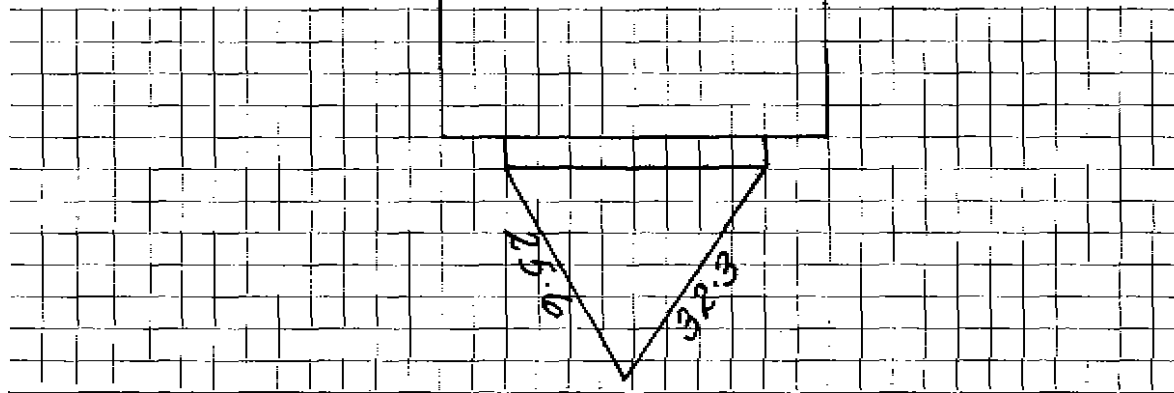

Connection made in _____ Street.

Work completed _____ 19

Remarks: