

WATER SERVICE RECORD

1486
Service No. 31

Name David Hawkins

Address 9 Belfry Terrace

Location


~~Repair~~ - Renewal - ~~New Service~~ X W.O. #8659

JUN 29 1964

Date	Material	Amount	Total	Date	Amount
5/11/64	Labor	77 52		4/15/64	300 00
	10% O.H.	7 75	85 27	6-29-64	132 42
11/4	3/4" Copper Tubing @ .42		47 88		167 58
1	3/4" Cx 1/2 I.W.H. Stop & Waste		6 17	8/26/63	
1	3/4" C3 Part Unions		2 41	22'	3/4 COPPER
8	Yards Loam @ 2.00		16 00	1	3/4 CORP
	Fert. & Lime		1 85	1	3/4 Curb Cock
	8 X 3 Patch		8 00		Box + Rod
			167 58		

WATER DIVISION

Sketch of Service Here

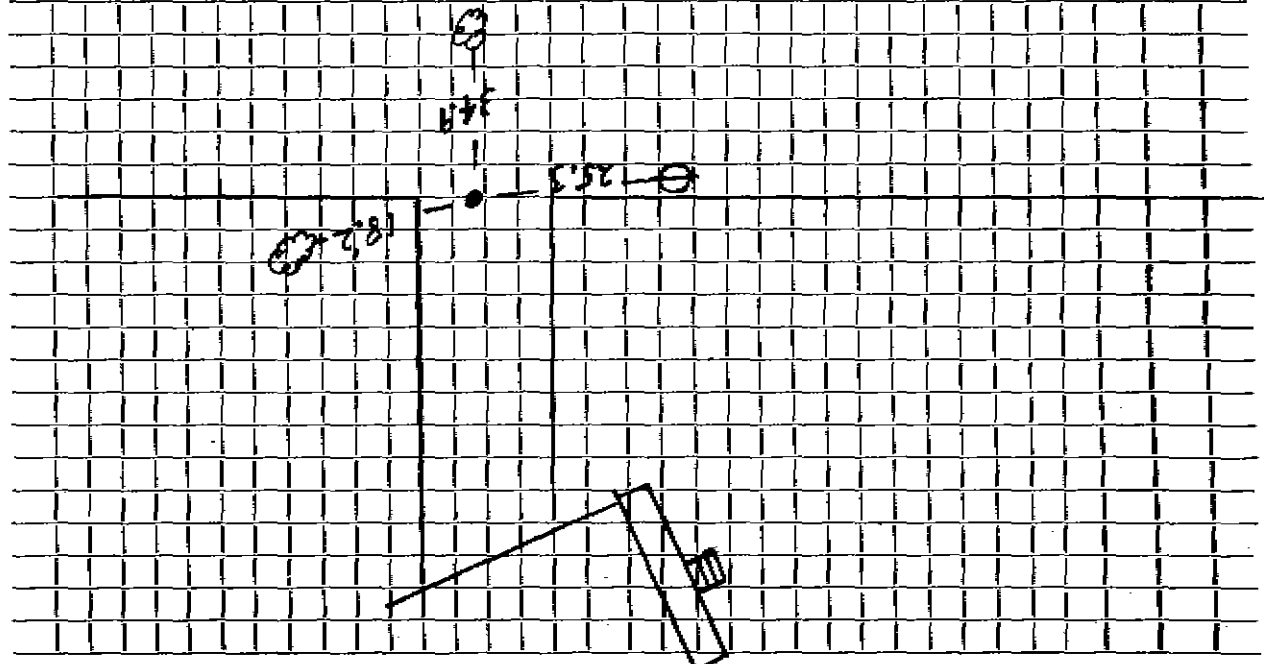

Connection made in _____ Street. Work completed _____

Remarks: _____