


TOWN OF LEXINGTON — BOARD OF PUBLIC WORKS

WATER DIVISION

Sketch of Service Here

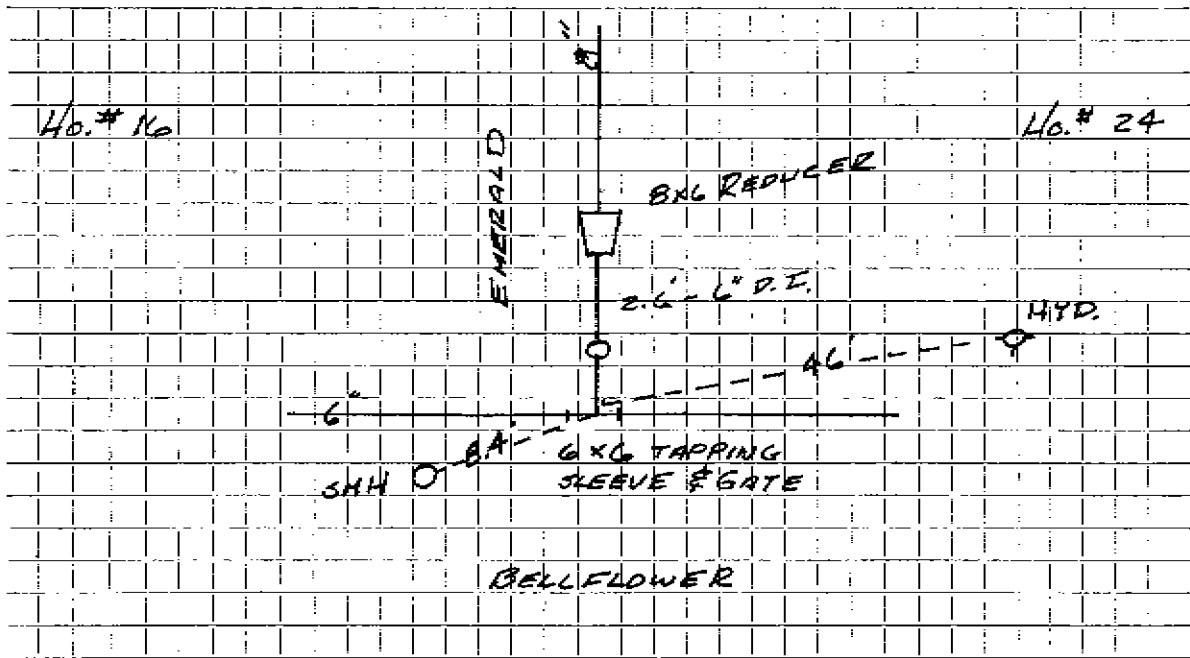

Connection made in BELLFLOWER Street. Work completed

Remarks: NEW 8" D.I. MAIN FOR EMERALD
J.T. & C - CONTRACTOR