

WATER SERVICE RECORD

Name Leland Const. Co.

Service No. 52A

Address 11 Bellflower Street

2444

Location Lexington

Repair ~~Renewal~~ New Service

Com. 6-16-52


Date	Material	Amount	Total	Date	Amount
5/13/52	Labor	3 76		4/15-52 Deposited	45 00
	10% overhead	38	4 14	6-16-52 Refunded	(7 36)
	40' - 3/4" copper tubing @ .3439	13 75			NON CHARGE
	1 - 3/4" C x 3/8" I.W.F. stop & waste	4 00	5/15/52 Labor		11 14
	3 hrs. town shovel @ 5.00	15 00		28' - 3/4" copper tubing @ .3439	9 63
	1 hr. trucking		75	1 - 3/4" C. corp-cock	4 33
			37 64	1 - 3/4" C x 3/4" C. curb-cock	4 67
				1 - box end rod	4 52
				1 - 1/2" straight tail piece	50
				1 - 1/2" offset tail piece	50
				2 hrs. town shovel @ 5.00	10 00
				1 hr. trucking	75
					46 04

DATE _____

TOWN OF LEXINGTON — BOARD OF PUBLIC WORKS

WATER DIVISION

Sketch of Service Here

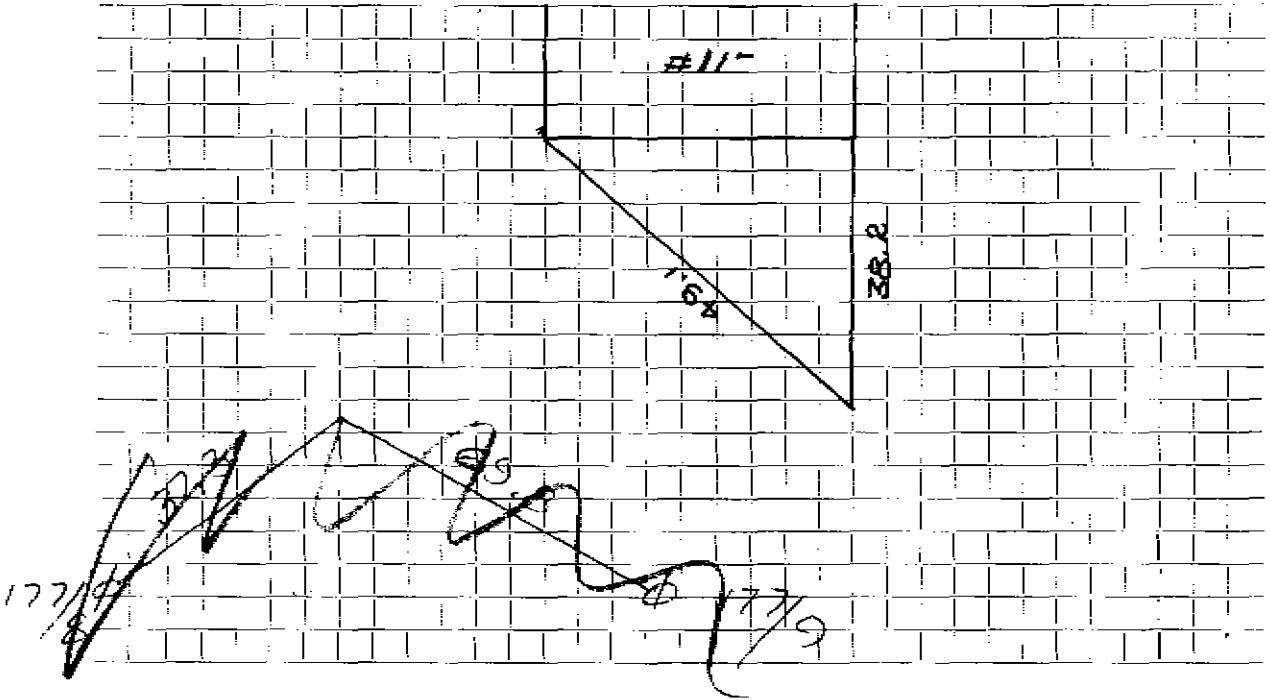

Connection made in Street. Work completed

Remarks:
.....
.....