

WATER SERVICE RECORD

Name Leland Construction Co.

Service No. 52A

Address 12 Bellflower Street

1846

Location Lexington

Repair—Renewal—New Service

Com. 6-16-52


Date	Material	Amount	Total	Date	Amount
5/13/52	Labor	3 75		4-15-52 Deposited	45 00
	10% overhead	38	4 13	6-10-52 Refunded	(6 68)
	42' - 3/4" copper tubing@.3439	14 44			<u>NON CHARGE</u>
	1 - 3/4" C x 3/8" I.W.F. stop-waste	4 00		5/15/52 Labor	11 14
	3 hrs. town shovel @ 5.00	15 00		12' - 3/4" copper tubing@.3439	4 13
	1 hr. trucking		75	1 - 3/4" C. corp-cock	4 33
			38 32	1 - 3/4" C x 3/4" C. curb-cock	4 67
				1 - box and rod	4 52
				1 - 3/8" offset tail piece	50
				1 - 1/2" straight tail piece	50
				1 hr. town shovel	5 00
				1 hr. trucking	75
					<u>35 54</u>

DATE _____

TOWN OF LEXINGTON — BOARD OF PUBLIC WORKS

WATER DIVISION

Sketch of Service Here

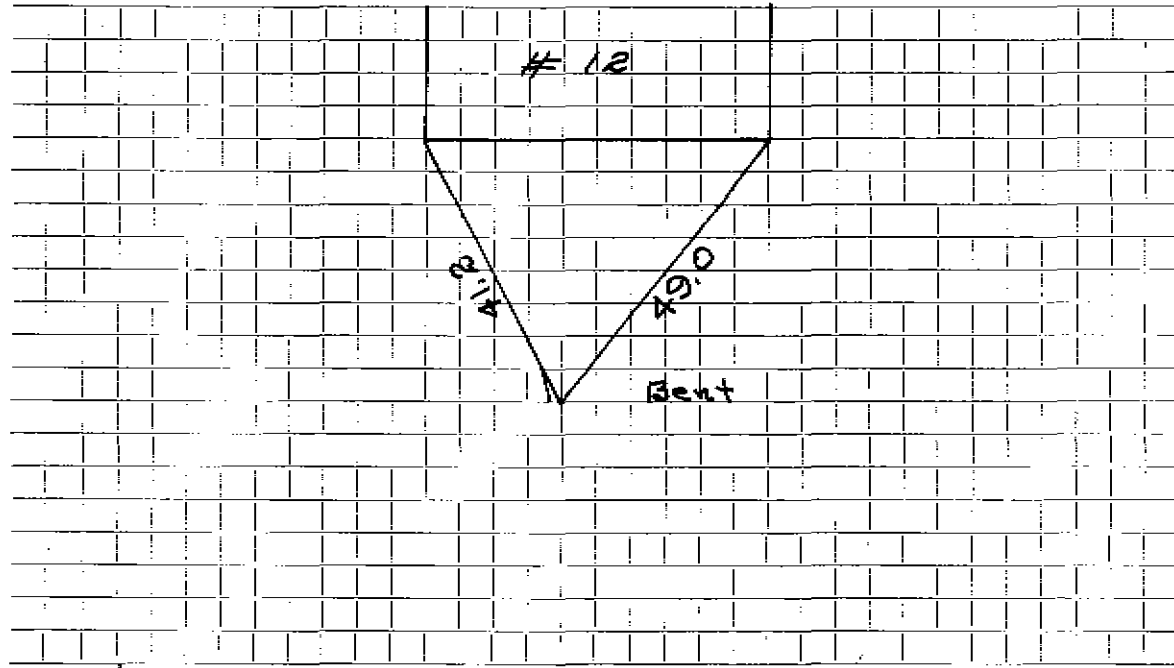

Connection made in Street. Work completed

Remarks:
.....
.....