

WATER SERVICE RECORD

#5211

Name Leland Const. Co.

Service No. 52A

Address 16 Bellflower Street

Location Lexington

~~Repair or Renewal~~ - New Service

Com. 6-16-52


Date	Material	Amount	Total	Date	Amount
5/13/52	Labor	3 76		4-15-52 Deposited	45 00
	10% overhead	38	4 14	6-16-52 Refunded	(5 64)
	45' - 3/4" copper tubing @ .3439-15	47			NON CHARGE
	1 - 3/4" C x 3/8" I.W.H. stop & waste	4 00	5/25/52 Labor		11 14
	3 hrs. town shovel	15 00		15' - 3/4" copper tubing @ .3439	5 15
	1 hr. trucking	75		1 - 3/4" C. corp-cock	4 33
			39 36	1 - 3/4" C x 3/4" C. curb-cock	4 67
				1 box and rod	4 52
				1 - 1/2" offset tail piece	50
				1 - 1/2" straight tail piece	50
				1 hr. town shovel	5 00
				1 hr. trucking	75
					36 56

DATE _____

TOWN OF LEXINGTON — BOARD OF PUBLIC WORKS

WATER DIVISION

Sketch of Service Here

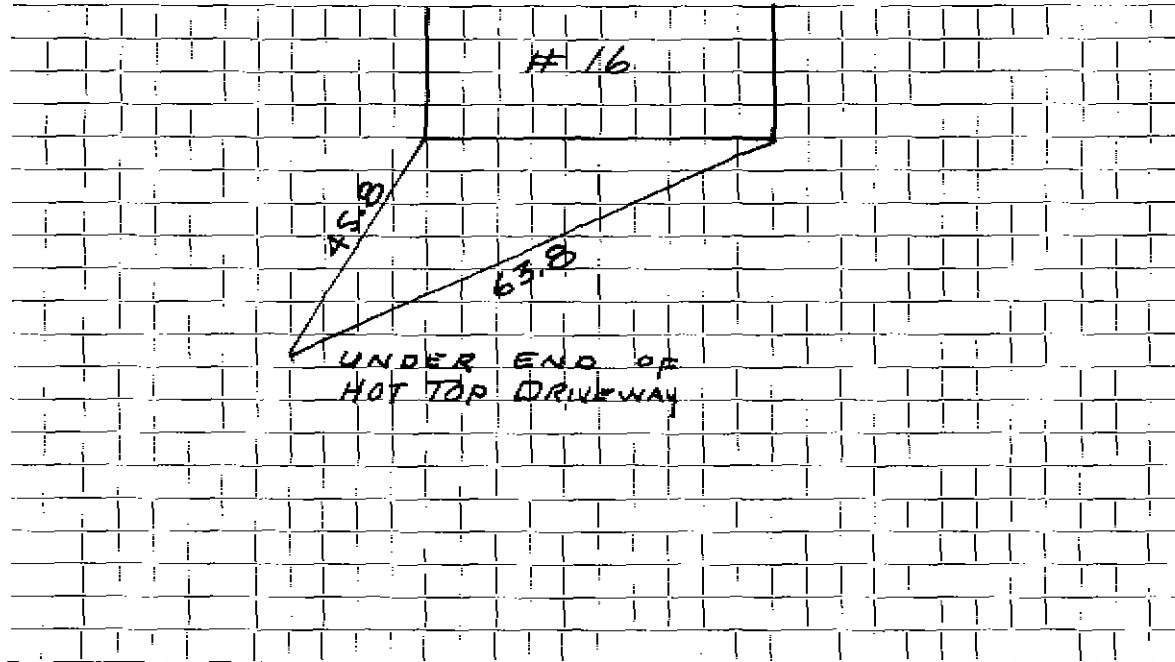

Connection made in Street. Work completed

Remarks:

.....

.....